WATER WELL RECORD Form WWC-5 KSA 82a-1212

1 LOCATION OF WATER WELL:	Fraction	Section Number	Township Number	Range Number
County: **Washington**	SE ¼ NE ¼ SW ¼	7	T 2 S	R 5 (E)/W

Distance and direction from nearest town or city street address of well if located within city?
~1/2 mi S of Hanover Ave/Yukon Blvd.

2 WATER WELL OWNER: **Magellan Ammonia Pipeline Co.**
RR#, St. Address, Box # : **One Williams Center, MD 30-7**
City, State, ZIP Code : **Tulsa, OK 74172**
Board of Agriculture, Division of Water Resources Application Number:

3 LOCATE WELL'S LOCATION WITH AN "X" IN SECTION BOX:

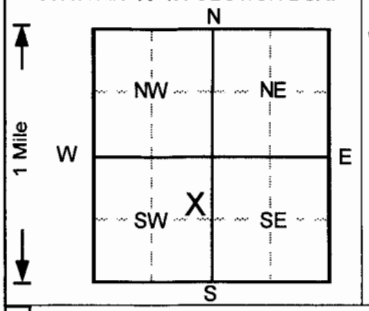

4 DEPTH OF COMPLETED WELL **60** ft. ELEVATION:
Depth(s) Groundwater Encountered 1. . . . ft. 2. . . . ft. 3. . . . ft.
WELL'S STATIC WATER LEVEL . . . . ft. below land surface measured on mo/day/yr . . . .
Pump test data: Well water was **NA** ft. after . . . hours pumping . . . gpm
Est. Yield **NA** gpm: Well water was . . . ft. after . . . hours pumping . . . gpm
Bore Hole Diameter **8** in. to **60** ft., and . . . in. to . . . ft.
WELL WATER TO BE USED AS: 5 Public water supply 8 Air conditioning 11 Injection well
1 Domestic 3 Feedlot 6 Oil field water supply 9 Dewatering 12 Other (Specify below)
2 Irrigation 4 Industrial 7 Lawn and garden only (10) Monitoring well
Was a chemical/bacteriological sample submitted to Department? Yes.....No ✓ ; If yes, mo/day/yr sample was submitted
Water Well Disinfected? Yes No ✓

5 TYPE OF BLANK CASING USED: 5 Wrought iron 8 Concrete tile CASING JOINTS: Glued . . . Clamped . . .
1 Steel 3 RMP (SR) 6 Asbestos-Cement 9 Other (specify below) Welded . . .
(2) PVC 4 ABS 7 Fiberglass Threaded ✓
Blank casing diameter **2** in. to **20** ft., Dia . . . in. to . . . ft., Dia . . . in. to . . . ft.
Casing height above land surface **30** in., weight . . . lbs./ft. Wall thickness or gauge No. **Sch. 40**

TYPE OF SCREEN OR PERFORATION MATERIAL
1 Steel 3 Stainless steel 5 Fiberglass (7) PVC 10 Asbestos-cement
2 Brass 4 Galvanized steel 6 Concrete tile 8 RMP (SR) 11 Other (specify) . . .
9 ABS 12 None used (open hole)

SCREEN OR PERFORATION OPENINGS ARE:
1 Continuous slot (3) Mill slot 5 Gauzed wrapped 8 Saw cut 11 None (open hole)
2 Louvered shutter 4 Key punched 6 Wire wrapped 9 Drilled holes
7 Torch cut 10 Other (specify) . . .

SCREEN-PERFORATED INTERVALS: From **20** ft. to **40** ft., From . . . ft. to . . . ft.
From . . . ft. to . . . ft., From . . . ft. to . . . ft.
GRAVEL PACK INTERVALS: From **14** ft. to **60** ft., From . . . ft. to . . . ft.
From . . . ft. to . . . ft., From . . . ft. to . . . ft.

6 GROUT MATERIAL: 1 Neat cement (2) Cement grout (3) Bentonite 4 Other . . .
Grout Intervals: From **0** ft. to **2.5** ft., From **2.5** ft. to **14** ft., From . . . ft. to . . . ft.
What is the nearest source of possible contamination:
1 Septic tank 4 Lateral lines 7 Pit privy 10 Livestock pens 14 Abandoned water well
2 Sewer lines 5 Cess pool 8 Sewage lagoon 11 Fuel storage 15 Oil well/Gas well
3 Watertight sewer lines 6 Seepage pit 9 Feedyard 12 Fertilizer storage 16 Other (specify below)
13 Insecticide storage . . .
Direction from well? How many feet?

FROM	TO	LITHOLOGIC LOG	FROM	TO	PLUGGING INTERVALS
0	1	Topsoil,			
1	15.5	Clay,			
15.5	30	Shale, weathered,			
30	56	Shale,			
56	60	Siltstone,			
					MW1

7 CONTRACTOR'S OR LANDOWNER'S CERTIFICATION: This water well was (1) constructed, (2) reconstructed, or (3) plugged under my jurisdiction and was completed on (mo/day/year) **9/30/2008** and this record is true to the best of my knowledge and belief. Kansas Water Well Contractor's License No. **527** This Water Well Record was completed on (mo/day/yr) **10/15/2008** under the business name of **GeoCore, Inc.** by (signature) Dale Hall

INSTRUCTIONS: Use typewriter or ball point pen. *PLEASE PRESS FIRMLY* and *PRINT* clearly. Please fill in blanks, underline or circle the correct answers. Send top three copies to Kansas Department of Health and Environment, Bureau of Water, Topeka, Kansas 66620-0001. Telephone: 913-296-5545. Send one to WATER WELL OWNER and retain one for your records.

OFFICE USE ONLY T R E/W SEC. ¼ ¼ ¼