

WATER WELL RECORD

Form WWC-5


Division of Water Resources; App. No.

MW-22

1 LOCATION OF WATER WELL: County: Washington Fraction NW 1/4 SW 1/4 NE 1/4 Section Number 9 Township Number T 2 S Range Number R 5 EW

Distance and direction from nearest town or city street address of well if located within city? Global Positioning Systems (decimal degrees, min. of 4 digits) Latitude: 39.8945 Longitude: -96.84852 Elevation: 1319.92 Datum: Data Collection Method:

2 WATER WELL OWNER: United States Dept of Agriculture RR#, St. Address, Box # : Attn: Mr Steve Gilmore City, State, ZIP Code : 1400 Independence Ave SW Washington, DC 20250-0513

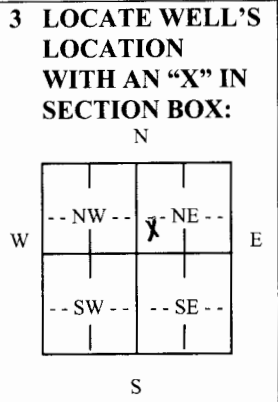

3 LOCATE WELL'S LOCATION WITH AN "X" IN SECTION BOX: 4 DEPTH OF COMPLETED WELL: 25 ft. Depth(s) Groundwater Encountered (1)..... ft. (2)..... ft. (3)..... ft. WELL'S STATIC WATER LEVEL..... ft. below land surface measured on mo/day/yr..... Pump test data: Well water was.....ft. after..... hours pumping..... gpm Est. Yield.....gpm: Well water was.....ft. after..... hours pumping..... gpm WELL WATER TO BE USED AS: 5 Public water supply 8 Air conditioning 11 Injection well 1 Domestic 3 Feedlot 6 Oil field water supply 9 Dewatering 12 Other (Specify below) 2 Irrigation 4 Industrial 7 Domestic (lawn & garden) 10 Monitoring well Was a chemical/bacteriological sample submitted to Department? Yes ..... No ..X....; If yes, mo/day/yr Sample was submitted..... Water well disinfected? Yes ..... No ..X....

5 TYPE OF CASING USED: 5 Wrought Iron 8 Concrete tile CASING JOINTS: Glued..... Clamped..... 1 Steel 3 RMP (SR) 6 Asbestos-Cement 9 Other (specify below) Welded..... 2 PVC 4 ABS 7 Fiberglass ..... Threaded..... Flush

Blank casing diameter ..... 2 ..... in. to ..... 15 ..... ft., Diameter..... in. to ..... ft., Diameter ..... in. to ..... ft. Casing height above land surface..... 0 ..... in., Weight ..... lbs./ft. Wall thickness or gauge No. .... 280 TYPE OF SCREEN OR PERFORATION MATERIAL: 1 Steel 3 Stainless Steel 5 Fiberglass 7 PVC 9 ABS 11 Other (Specify) ..... 2 Brass 4 Galvanized Steel 6 Concrete tile 8 RM (SR) 10 Asbestos-Cement 12 None used (open hole)

SCREEN OR PERFORATION OPENINGS ARE: 1 Continuous slot 3 Mill slot 5 Gauzed wrapped 7 Torch cut 9 Drilled holes 11 None (open hole) 2 Louvered shutter 4 Key punched 6 Wire wrapped 8 Saw Cut 10 Other (specify) .....

SCREEN-PERFORATED INTERVALS: From..... 25 ..... ft. to ..... 18 ..... ft., From ..... ft. to ..... ft. From..... ft. to ..... ft., From ..... ft. to ..... ft. GRAVEL PACK INTERVALS: From..... 29 ..... ft. to ..... 16 ..... ft., From ..... ft. to ..... ft. From..... ft. to ..... ft., From ..... ft. to ..... ft.

6 GROUT MATERIAL: 1 Neat cement 2 Cement grout 3 Bentonite 4 Other Concrete Grout Intervals: From .... 13 ..... ft. to ..... 2 ..... ft., From .... 2 ..... ft. to ..... 0 ..... ft., From ..... ft. to ..... ft.

What is the nearest source of possible contamination: 1 Septic tank 4 Lateral lines 7 Pit privy 10 Livestock pens 13 Insecticide Storage 16 Other (specify below) 2 Sewer lines 5 Cess pool 8 Sewage lagoon 11 Fuel storage 14 Abandoned water well 12 Fertilizer Storage 15 Oil well/gas well 3 Watertight sewer lines 6 Seepage pit 9 Feedyard Direction from well? ..... How many feet? .....

Table with columns: FROM, TO, LITHOLOGIC LOG, FROM, TO, PLUGGING INTERVALS. Row 1: FROM 0 TO 11, Brn CLAY w/gravel. Row 2: FROM 11 TO 29, Tan weathered BEBROCK.

7 CONTRACTOR'S OR LANDOWNER'S CERTIFICATION: This water well was 1 constructed, (2) reconstructed, or (3) plugged under my jurisdiction and was completed on (mo/day/year) 02/27/2009 and this record is true to the best of my knowledge and belief. Kansas Water Well Contractor's License No. ... 658 ..... This Water Well Record was completed on (mo/day/year) ... 03/16/2009 ... under the business name of Boart Longyear by (signature) [Signature]

INSTRUCTIONS: Use typewriter or ball point pen. PLEASE PRESS FIRMLY and PRINT clearly. Please fill in blanks, underline or circle the correct answers. Send top three copies to Kansas Department of Health and Environment, Bureau of Water, Geology Section, 1000 SW Jackson St., Suite 420, Topeka, Kansas 66612-1367. Telephone 785-296-5522. Send one to WATER WELL OWNER and retain one for your records. Fee of \$5.00 for each constructed well. Visit us at http://www.kdheks.gov/waterwell/index.html.