

CORRECTED

WATER WELL RECORD


Form WWC-5

Division of Water Resources App. No.

1 LOCATION OF WATER WELL: County: Washington Fraction NW 1/4 NE 1/4 NW 1/4 SW 1/4 Section Number 09 Township No. T 2 S Range Number R 05 [X] E [ ] W

Street/Rural Address of Well Location; if unknown, distance & direction from nearest town or intersection: If at owner's address, check here [ ] 200 W North St Hanover, KS Global Positioning System (GPS) information: Latitude: 39.89274 Longitude: 96.87775 Elevation: 1242.09

2 WATER WELL OWNER: Michael/Virginia Mince RR#, Street Address, Box #: 414 N Denver Ave City, State, ZIP Code : Hanover, KS 66945 Collection Method: [ ] GPS unit [ ] Digital Map/Photo [ ] Topographic Map [X] Land Survey

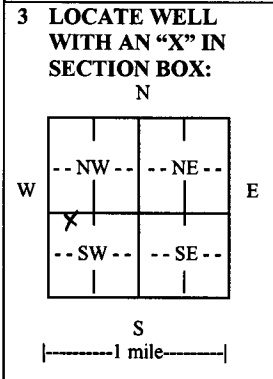

3 LOCATE WELL WITH AN 'X' IN SECTION BOX: N W E S 4 DEPTH OF COMPLETED WELL 32. Depth(s) Groundwater Encountered (1) -22.0 (2) (3) WELL'S STATIC WATER LEVEL 27.65 ft. below land surface measured on mo/day/yr. 3-16-15

5 TYPE OF CASING USED: [ ] Steel [X] PVC [ ] Other CASING JOINTS: [ ] Glued [ ] Clamped [ ] Welded [X] Threaded Casing diameter 2 in. to 17 ft., Diameter in. to ft., Diameter in. to ft. Casing height above land surface -0.28 in., Weight lbs./ft., Wall thickness or gauge No. sch 40

6 GROUT MATERIAL: [ ] Neat cement [ ] Cement grout [X] Bentonite [ ] Other Grout Intervals: From 1 ft. to 15 ft., From ft. to ft., From ft. to ft., From ft. to ft. What is the nearest source of possible contamination: [ ] Septic tank [ ] Lateral lines [ ] Pit privy [ ] Livestock pens [ ] Insecticide storage [ ] Other (specify below)

Table with columns: FROM, TO, LITHOLOGIC LOG, FROM, TO, LITHO. LOG (cont.) or PLUGGING INTERVALS. Rows include: 0-1 Concrete, 1-12 Clay, silty, dark brown. CH, 12-23 Clay, silty, brown. CH, 23-26 Clay, silty, grey. CH, 26-32 Shale, grey, MW9.

7 CONTRACTOR'S OR LANDOWNER'S CERTIFICATION: This water well was [X] constructed, [ ] reconstructed, or [ ] plugged under my jurisdiction and was completed on (mo/day/year) 03/17/2014 and this record is true to the best of my knowledge and belief. Kansas Water Well Contractor's License No. 594 This Water Well Record was completed on (mo/day/year) 05-05-15 under the business name of Coranco Great Plains, Inc. by (signature)

INSTRUCTIONS: Use typewriter or ball point pen. PLEASE PRESS FIRMLY and PRINT clearly. Please fill in blanks and check the correct answers. Send one copy to Kansas Department of Health and Environment, Bureau of Water, Geology Section, 1000 SW Jackson St., Suite 420, Topeka, Kansas 66612-1367. Telephone 785-296-5524. Send one copy to WATER WELL OWNER and retain one for your records. Include fee of \$5.00 for each constructed well. Visit us at