

**WATER WELL PLUGGING RECORD Form WWC-5P KSA 82a-1212 ID NO.**

**MW5**

<b>1 LOCATION OF WATER WELL:</b> County: Washington	Fraction SW¼ SE¼ NE¼	Section Number 9	Township Number T 2 S	Range Number 5 <input checked="" type="checkbox"/> E <input type="checkbox"/> W
--	-------------------------	---------------------	--------------------------	--

Street/Rural Address of Well Location; if unknown, distance & direction from nearest town or intersection: If at owner's address, check here <input type="checkbox"/> 200 W North St, Hanover, KS	<b>Global Positioning Systems (GPS) information:</b> Latitude: _____ (in decimal degrees) Longitude: _____ (in decimal degrees) Elevation: _____
	Horizontal Datum <input type="checkbox"/> WGS84, <input type="checkbox"/> NAD83, <input type="checkbox"/> NAVD27 Collection Method: <input type="checkbox"/> GPS unit (Make/model: _____) <input type="checkbox"/> Digital Map/Photo, <input type="checkbox"/> Topographic Map <input type="checkbox"/> Land Survey Est. Accuracy: <input type="checkbox"/> <3 m, <input type="checkbox"/> 3-5 m, <input type="checkbox"/> 5-15 m, <input type="checkbox"/> >15 m

**2 WATER WELL OWNER:** Bill's Service Center  
RR#, St. Address, Box #: 2832 Hilltop  
City, State ZIP Code: Hanover, KS 66945

**3 MARK WELL'S LOCATION WITH AN "X" IN SECTION BOX:**

**4 DEPTH OF WELL** 26.29 ft. MW5  
WELL'S STATIC WATER LEVEL \_\_\_\_\_ ft  
WELL WAS USED AS:  
 Domestic  Public Water Supply  Dewatering  
 Irrigation  Oil Field Water Supply  Monitoring  
 Feedlot  Domestic (Lawn & Garden)  Injection Well  
 Industrial  Air Conditioning  Other \_\_\_\_\_  
Was a chemical/bacteriological sample submitted to Department? Yes  No

**5 TYPE OF BLANK CASING USED:**

<input type="checkbox"/> Steel	<input type="checkbox"/> RMP (SR)	<input type="checkbox"/> Wrought	<input type="checkbox"/> Fiberglass	<input type="checkbox"/> Other (Specific below)
<input checked="" type="checkbox"/> PVC	<input type="checkbox"/> ABS	<input type="checkbox"/> Asbestos-Cement	<input type="checkbox"/> Concrete Tile	

Blank casing diameter 2 in. Was casing pulled? Yes  No  If yes, how much 2.66 ft  
Casing height above or below land surface NA in.

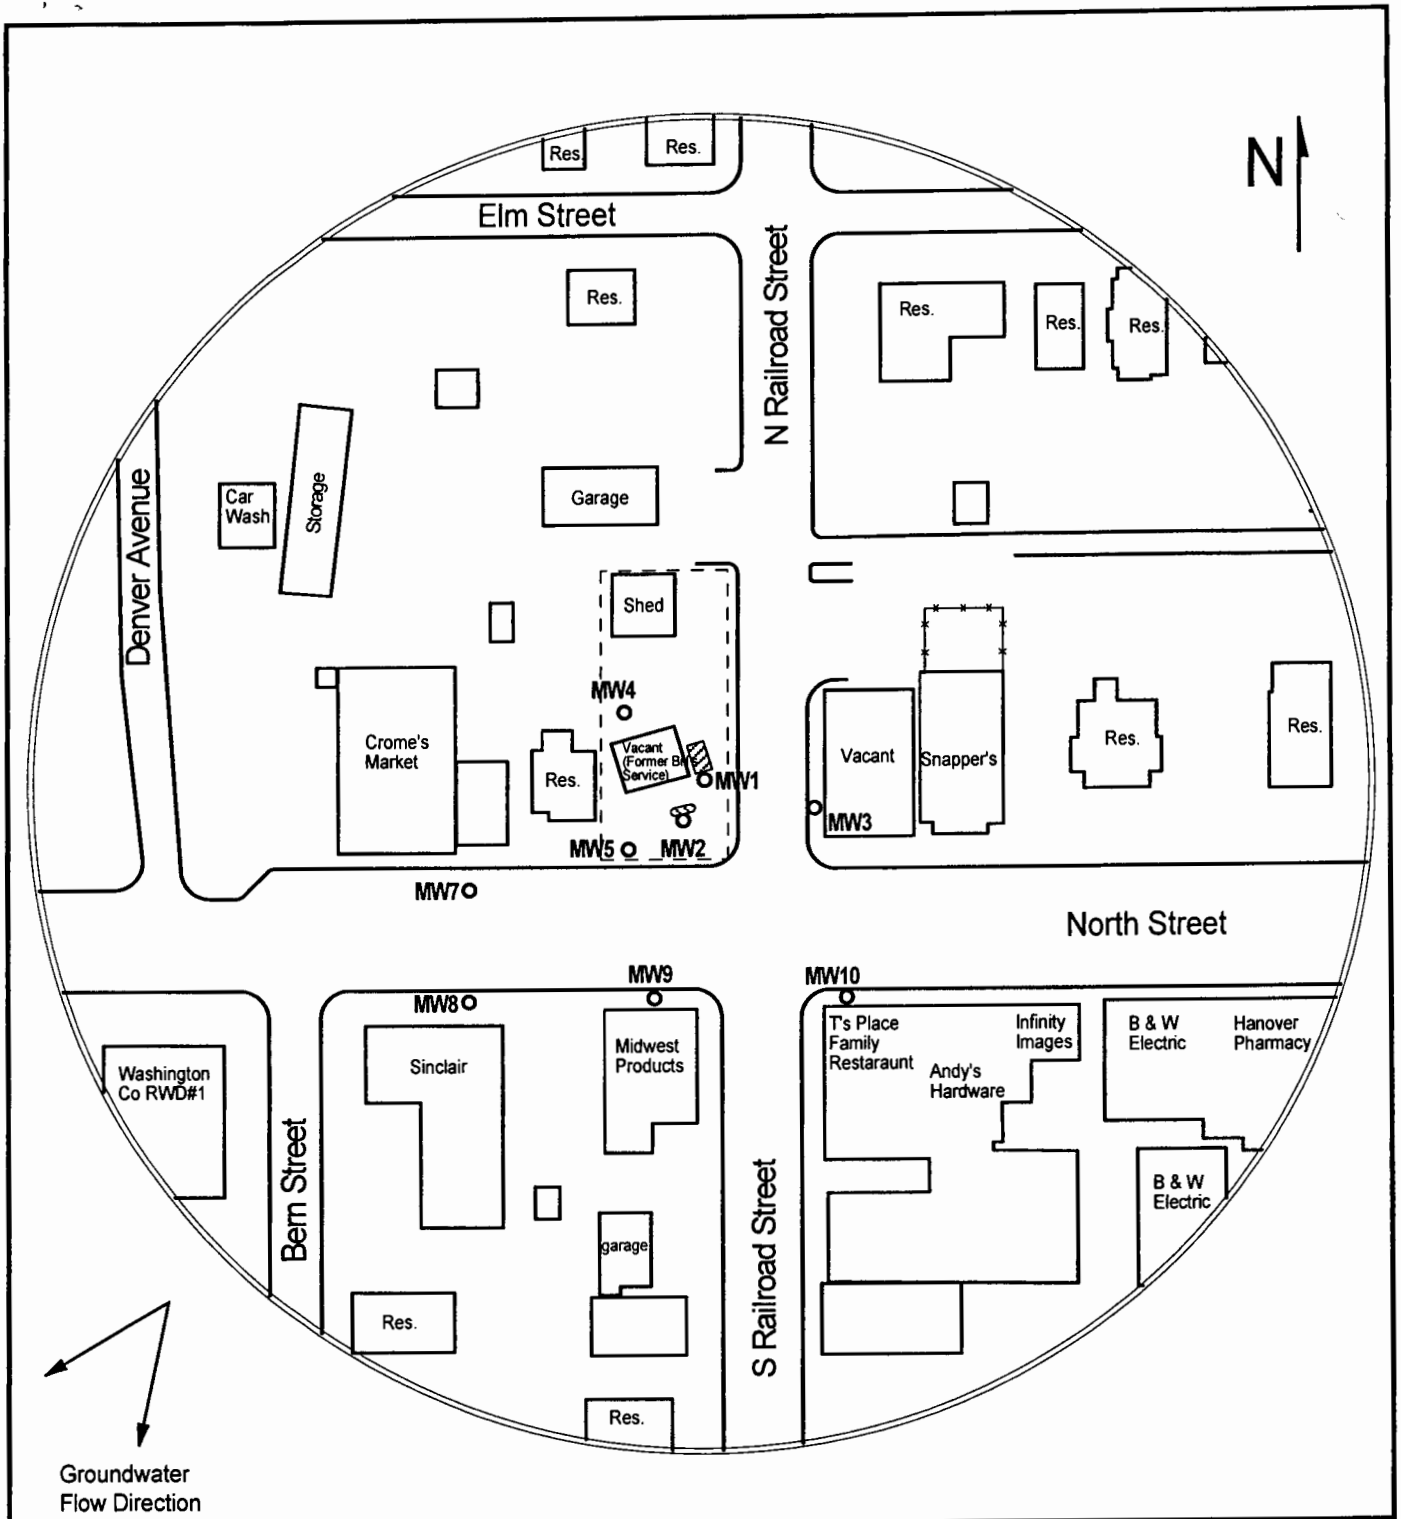
**6 GROUT PLUG MATERIAL:**  Neat cement  Cement grout  Bentonite  Other Concrete: 0-0.75'; Soil: 0.75-3'  
Grout Plug Intervals: From 3 ft to 26.29 ft, From \_\_\_\_\_ ft to \_\_\_\_\_ ft, From \_\_\_\_\_ ft to \_\_\_\_\_ ft.  
What is the nearest source of possible contamination:  
 Septic tank  Seepage pit  Fuel storage  Other (specify below)  
 Sewer lines  Pit privy  Fertilizer storage  
 Watertight sewer lines  Sewage lagoon  Insecticide storage  
 Lateral lines  Feed yard  Abandoned water well  
 Cess pool  Livestock pens  Oil well/Gas well  
Direction from well? \_\_\_\_\_  
How many feet? \_\_\_\_\_

FROM	TO	PLUGGING MATERIALS	FROM	TO	PLUGGING MATERIALS
0	0.75	Concrete			
0.75	3	Soil			
3	26.29	Bentonite			

KDHE ID: Bill's Service Center; U5-101-11774




**7 CONTRACTOR'S OR LANDOWNER'S CERTIFICATION:** This water well was plugged under my jurisdiction and was completed on (mo/day/year) 5/19-20/22 and this record is true to the best of my knowledge and belief. Kansas Water Contractor's License No. 757. This Water Well Record was completed on (mo/day/year) 6/1/22 under the business name of Larsen & Associates, Inc. By (signature) \_\_\_\_\_

Send one white copy to Kansas Department of Health & Environment, Geology Section, 1000 SW Jackson Street, Ste. 420, Topeka, KS 66612-1367. Send one copy to WATER WELL OWNER and retain one for your records  
Visit us at <http://www.kdheks.gov/waterwell/index.html> Telephone 785-296-5524.



**FIGURE 1 - SITE BASE MAP**

**LEGEND:**

-  Approximate Location of Former UST basin and Pump Island
-  Approximate Location of Property Line
-  Plugged Monitoring Well



**PROJECT:**

Bill's Service Center  
 200 W. North St.  
 Hanover, KS  
 KDHE ID: U5-101-11774  
 Date: 5/19, 20, & 27/22



1311 E 25th St., Suite B (785) 841-8707 office  
 Lawrence, KS 66046 (785) 865-4282 fax

NOTE: Location of product lines is unknown.