

**WATER WELL PLUGGING RECORD Form WWC-5P KSA 82a-1212 ID NO.**

**MW2**


**1 LOCATION OF WATER WELL:** Fraction SW 1/4 SE 1/4 NE 1/4 Section Number 9 Township Number T 2 S Range Number 5  E  W

County: Washington  
 Street/Rural Address of Well Location: if unknown, distance & direction from nearest town or intersection: If at owner's address, check here   
200 W North St, Hanover, KS

**Global Positioning Systems (GPS) information:**  
 Latitude: \_\_\_\_\_ (in decimal degrees)  
 Longitude: \_\_\_\_\_ (in decimal degrees)  
 Elevation: \_\_\_\_\_  
 Horizontal Datum  WGS84,  NAD83,  NAVD27  
 Collection Method: \_\_\_\_\_

**2 WATER WELL OWNER:** Bill's Service Center  
 RR#, St. Address, Box #: 2832 Hilltop  
 City, State ZIP Code: Hanover, KS 66945

GPS unit (Make/model): \_\_\_\_\_  
 Digital Map/Photo,  Topographic Map  Land Survey  
 Est. Accuracy:  <3 m,  3-5 m,  5-15 m,  >15 m

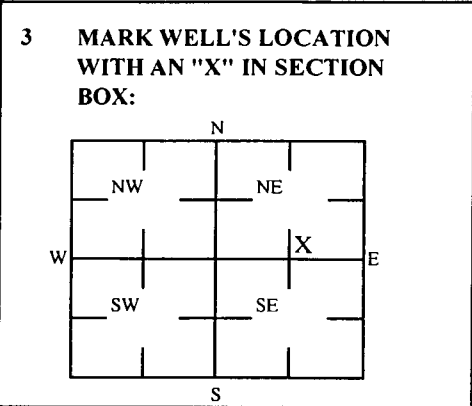

**4 DEPTH OF WELL** 29.61 ft. MW2  
 WELL'S STATIC WATER LEVEL \_\_\_\_\_ ft  
 WELL WAS USED AS:  
 Domestic  Public Water Supply  Dewatering  
 Irrigation  Oil Field Water Supply  Monitoring  
 Feedlot  Domestic (Lawn & Garden)  Injection Well  
 Industrial  Air Conditioning  Other \_\_\_\_\_  
 Was a chemical/bacteriological sample submitted to Department? Yes  No

**5 TYPE OF BLANK CASING USED:**  
 Steel  RMP (SR)  Wrought  Fiberglass  Other (Specific below)  
 PVC  ABS  Asbestos-Cement  Concrete Tile  
 Blank casing diameter 2 in. Was casing pulled? Yes  No  If yes, how much 2.66 ft  
 Casing height above or below land surface NA in.


**6 GROUT PLUG MATERIAL:**  Neat cement  Cement grout  Bentonite  Other Concrete: 0-0.75'; Soil: 0.75-3'  
 Grout Plug Intervals: From 3 ft to 29.61 ft, From \_\_\_\_\_ ft to \_\_\_\_\_ ft, From \_\_\_\_\_ ft to \_\_\_\_\_ ft.  
 What is the nearest source of possible contamination:  
 Septic tank  Seepage pit  Fuel storage  Other (specify below) \_\_\_\_\_  
 Sewer lines  Pit privy  Fertilizer storage \_\_\_\_\_  
 Watertight sewer lines  Sewage lagoon  Insecticide storage \_\_\_\_\_  
 Lateral lines  Feed yard  Abandoned water well Direction from well? \_\_\_\_\_  
 Cess pool  Livestock pens  Oil well/Gas well How many feet? \_\_\_\_\_

FROM	TO	PLUGGING MATERIALS	FROM	TO	PLUGGING MATERIALS
0	0.75	Concrete			
0.75	3	Soil			
3	29.61	Bentonite			

KDHE ID: Bill's Service Center; U5-101-11774




**7 CONTRACTOR'S OR LANDOWNER'S CERTIFICATION:** This water well was plugged under my jurisdiction and was completed on (mo/day/year) 5/19-20/22 and this record is true to the best of my knowledge and belief. Kansas Water Contractor's License No. 757. This Water Well Record was completed on (mo/day/year) 6/1/22 under the business name of Larsen & Associates, Inc. By (signature) \_\_\_\_\_

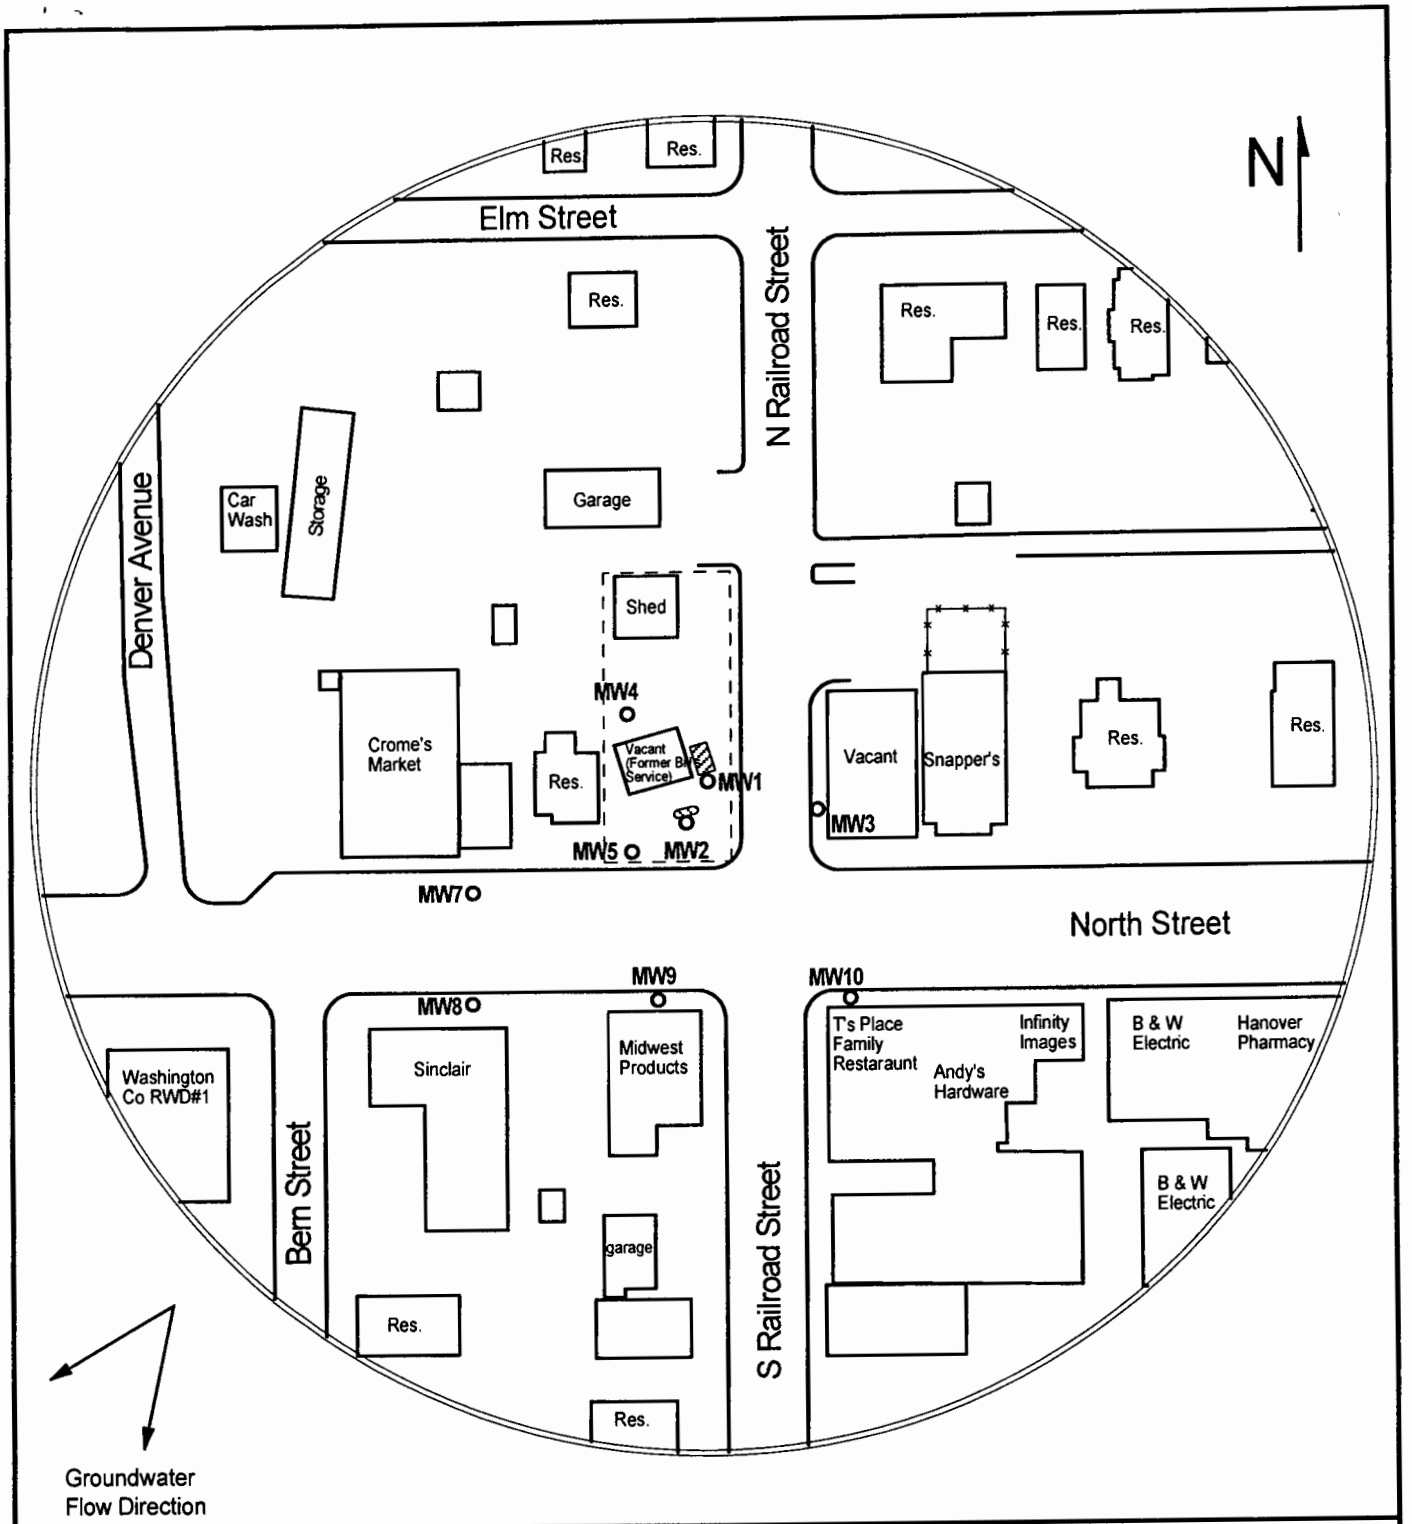Send one white copy to Kansas Department of Health & Environment, Geology Section, 1000 SW Jackson Street, Ste. 420, Topeka, KS 66612-1367. Send one copy to WATER WELL OWNER and retain one for your records  
 Visit us at <http://www.kdheks.gov/waterwell/index.html> Telephone 785-296-5524.



**FIGURE 1 - SITE BASE MAP**

**LEGEND:**

-  Approximate Location of Former UST basin and Pump Island
-  Approximate Location of Property Line
-  Plugged Monitoring Well



**PROJECT:**

Bill's Service Center  
200 W. North St.  
Hanover, KS  
KDHE ID: U5-101-11774  
Date: 5/19, 20, & 27/22



1311 E 25th St., Suite B (785) 841-8707 office  
Lawrence, KS 66046 (785) 865-4282 fax

NOTE: Location of product lines is unknown.