

USE TYPEWRITER OR BALL POINT PEN-PRESS FIRMLY, PRINT CLEARLY.


WATER WELL RECORD
KSA 82a-1201-1215

Kansas Department of Health and Environment-Division of Health (Water well Contractors) Topeka, Kansas 66620

1. Location of well: County Washington Section 9 Township number T 25 S R 5 E Range number 5 E E/W

South east Part
Location in Hanover
NE 1/4 SE 1/4 SE 1/4

Distance and direction from nearest town or city: 1/2 mile S
Street address of well location if in city:
3. Owner of well: Harold Neumann
R.R. or street:
City, state, zip code: Hanover Kans

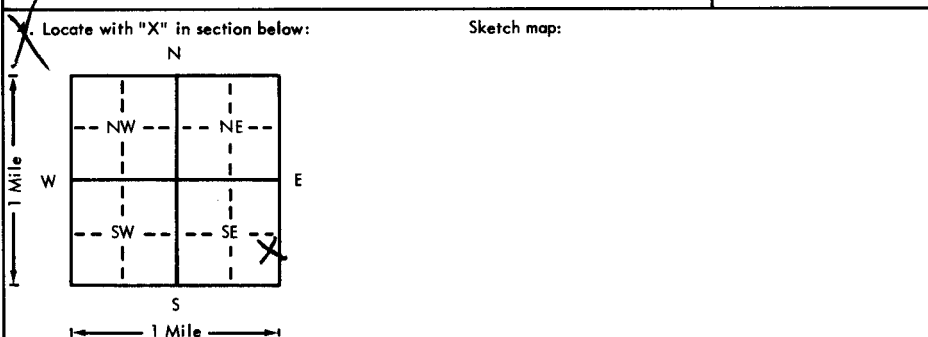

6. Bore hole dia. 11 in. Completion date Aug 24-76
Well depth 60 ft.

7. Cable tool Rotary Driven Dug
 Hollow rod Jetted Bored Reverse rotary

8. Use: Domestic Public supply Industry
 Irrigation Air conditioning Stock
 Lawn Oil field water Other

Casing: Material steel Height: Above or below
Threaded Welded Surface 12 in.
RMP PVC Weight 20 lbs./ft.
Dia. 3/4 in. to 60 ft. depth Well thickness 3/8 in. or 1/2 in. 2 7/2 W'al
Dia. 5 in. to 60 ft. depth gage No. 857

5. Type and color of material	From	To
<u>top soil</u>	<u>0</u>	<u>10</u>
<u>clay, red</u>	<u>10</u>	<u>15</u>
<u>clay Blue</u>	<u>15</u>	<u>24</u>
<u>clay Red hard</u>	<u>24</u>	<u>60</u>
<u>Rock</u>	<u>60</u>	

10. Screen: Manufacturer's name P.M.P. Pumped
Type P.V.C. Dia. 5"
Slot/gauge 0.50 Length 20
Set between 40 ft. and 60 ft.
ft. and 60 ft.
Gravel pack? Size range of material 8x1/4

11. Static water level: 30 ft. below land surface Date 8-24-76 mo./day/yr.

12. Pumping level below land surfaces:
____ ft. after ____ hrs. pumping ____ g.p.m.
____ ft. after ____ hrs. pumping ____ g.p.m.
Estimated maximum yield 10 g.p.m.

13. Water sample submitted: ____ mo./day/yr.
Yes No Date

14. Well head completion: NA
____ Pitless adapter ____ Inches above grade

15. Well grouted?
With: ____ Neat cement ____ Bentonite Concrete
Depth: From 12 ft. to top ft.

16. Nearest source of possible contamination: ditch (dry)
ft. 30 Direction south Type ditch
Well disinfected upon completion? Yes No

17. Pump: Not installed
Manufacturer's name
Model number ____ HP ____ Volts ____
Length of drop pipe ____ ft. capacity ____ g.p.m.
Type:
____ Submersible ____ Turbine
____ Jet ____ Reciprocating
____ Centrifugal ____ Other

18. Elevation: 1240 ft
Topography:
 Hill
 Slope
 Upland
 Valley

19. Remarks:

20. Water well contractor's certification:
This well was drilled under my jurisdiction and this report is true to the best of my knowledge and belief.
Strader Drilling Co. 23
Business name Blue Rapids License No.
Address Hanover Kans
Signed Harold Strader Date 8-24-76
Authorized representative

T 25 S R 5 E
Sec 9
NE 1/4 SE 1/4