

USE TYPEWRITER OR BALL POINT PEN-PRESS FIRMLY, PRINT CLEARLY.


WATER WELL RECORD
KSA 82a-1201-1215

Kansas Department of Health and Environment—Division of Environment
(Water well Contractors)
Topeka, Kansas 66620

3/2 Jedicheston in Hanover Name

1. Location of well: County Washington Section number 9 Township number T 25 S Range number R 5 E
 Location: NW 1/4 SW 1/4 SE 1/4 E/W

2. Distance and direction from nearest town or city: in Hanover
 Street address of well location if in city: in S.W. Part
 3. Owner of well: Joe Wallenberg
 R.R. or street: Hanover Kans
 City, state, zip code:

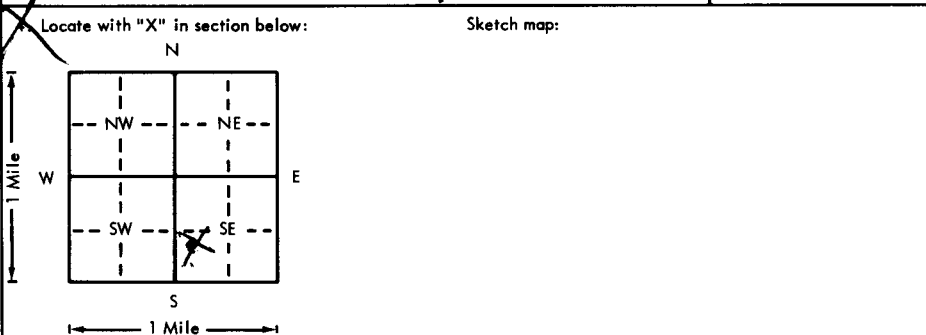

6. Bore hole dia. 1 1/2 in. Completion date 7-20-76
 Well depth 62 ft.
 7. Cable tool Rotary Driven Dug
 Hollow rod Jetted Bored Reverse rotary
 8. Use: Domestic Public supply Industry
 Irrigation Air conditioning Stock
 Lawn Oil field water Other
 9. Casing: Material STEEL Height: Above or below
 Threaded Welded Surface 12 in.
 RMP PVC Weight 20 lbs./ft.
 Dia. 6 1/2 in. to 57 ft. depth Wall Thickness: inches or
 Dia. in. to ft. depth Gauge No. 267

5. Type and color of material	From	To
<u>top soil</u>	<u>0</u>	<u>4</u>
<u>clay joint, yellow</u>	<u>4</u>	<u>40</u>
<u>Sand clay & rock</u>	<u>40</u>	<u>58</u>
<u>Shale Blue</u>	<u>58</u>	<u>62</u>

10. Screen: Manufacturer's name Acme Sounding
 Type PVC Dia. 5"
 Slot/groove .050 Length 20
 Set between 42 ft. and 62 ft.
 ft. and ft.
 Gravel pack? Size range of material 5/16"
 11. Static water level: 40 ft. below land surface Date 7-20-76 mo./day/yr.
 12. Pumping level below land surfaces:
 ft. after hrs. pumping g.p.m.
 ft. after hrs. pumping g.p.m.
 Estimated maximum yield 10 g.p.m.
 13. Water sample submitted: mo./day/yr.
 Yes No Date
 14. Well head completion: NA
 Pitless adapter inches above grade
 15. Well grouted?
 With: Neat cement Bentonite Concrete
 Depth: From 14 ft. to 4 ft.
 16. Nearest source of possible contamination:
 ft. 110 Direction north Type Creek
 Well disinfected upon completion? Yes No
 17. Pump: Not installed
 Manufacturer's name
 Model number HP Volts
 Length of drop pipe ft. capacity g.p.m.
 Type:
 Submersible Turbine
 Jet Reciprocating
 Centrifugal Other

(Use a second sheet if needed)

18. Elevation: _____
 19. Remarks: _____
 Topography:
 Hill
 Slope
 Upland
 Valley
 20. Water well contractor's certification:
 This well was drilled under my jurisdiction and this report is true to the best of my knowledge and belief.
Strader Drilling Co 237
 Business name License No.
 Address Blue Robins
 Signed Harold Strader Date 7-20-76
 Authorized representative

T-20
R-5E
Q-9
NW 1/4
SW 1/4
SE 1/4