WATER WELL RECORD Form WWC-5 KSA 82a-1212

1 LOCATION OF WATER WELL: County: Washington | Fraction: NW ¼ NW ¼ NW ¼ | Section Number: 16 | Township Number: T 2 S | Range Number: R 5 (E) W

Distance and direction from nearest town or city street address of well if located within city? SW Edge Hanover ks.

2 WATER WELL OWNER: Duane Brand

RR#, St. Address, Box # : Rt 1

City, State, ZIP Code : Hanover Ks.

Board of Agriculture, Division of Water Resources Application Number:

3 LOCATE WELL'S LOCATION WITH AN "X" IN SECTION BOX:

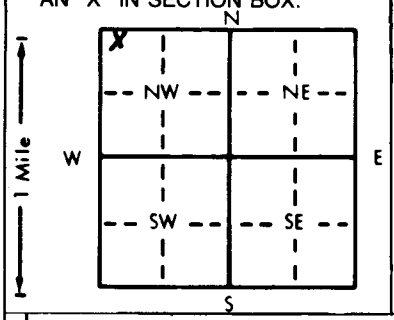

4 DEPTH OF COMPLETED WELL 45 ft. ELEVATION: 1210

Depth(s) Groundwater Encountered 1. ..... ft. 2. ..... ft. 3. ..... ft.

WELL'S STATIC WATER LEVEL 27 ft. below land surface measured on mo/day/yr June 24 88

Pump test data: Well water was ..... ft. after ..... hours pumping ..... gpm

Est. Yield 30 gpm: Well water was ..... ft. after ..... hours pumping ..... gpm

Bore Hole Diameter 9 in. to 45 ft., and ..... in. to ..... ft.

WELL WATER TO BE USED AS: 1 Domestic 3 Feedlot 6 Oil field water supply 9 Dewatering 12 Other (Specify below)
2 Irrigation 4 Industrial 7 Lawn and garden only 10 Monitoring well 5 Public water supply 8 Air conditioning 11 Injection well

Was a chemical/bacteriological sample submitted to Department? Yes ..... No ✓ ; If yes, mo/day/yr sample was submitted ..... Water Well Disinfected? Yes ✓ No

5 TYPE OF BLANK CASING USED: 1 ~~Steel~~ 2 PVC ✓ 3 RMP (SR) 4 ABS 5 Wrought iron 6 Asbestos-Cement 7 Fiberglass 8 Concrete tile 9 Other (specify below)

CASING JOINTS: Glued ✓ Clamped ..... Welded ..... Threaded .....

Blank casing diameter 5 in. to 35 ft., Dia ..... in. to ..... ft., Dia ..... in. to ..... ft.

Casing height above land surface 18 in., weight 200 lbs./ft. Wall thickness or gauge No. .....

TYPE OF SCREEN OR PERFORATION MATERIAL: ~~7 PVC~~

1 Steel 3 Stainless steel 5 Fiberglass 8 RMP (SR) 10 Asbestos-cement
2 Brass 4 Galvanized steel 6 Concrete tile 9 ABS 11 Other (specify) ..... 12 None used (open hole)

SCREEN OR PERFORATION OPENINGS ARE: 1 Continuous slot 2 Louvered shutter 3 Mill slot 4 Key punched 5 Gauzed wrapped 6 Wire wrapped 7 Torch cut ~~8 Saw cut~~ 9 Drilled holes 10 Other (specify) ..... 11 None (open hole)

SCREEN-PERFORATED INTERVALS: From 35 ft. to 45 ft., From ..... ft. to ..... ft.

From ..... ft. to ..... ft., From ..... ft. to ..... ft.

GRAVEL PACK INTERVALS: From 35 ft. to 45 ft., From ..... ft. to ..... ft.

From ..... ft. to ..... ft., From ..... ft. to ..... ft.

6 GROUT MATERIAL: 1 Neat cement 2 Cement grout ~~3 Bentonite~~ 4 Other .....

Grout Intervals: From 0 ft. to 35 ft., From ..... ft. to ..... ft., From ..... ft. to ..... ft.

What is the nearest source of possible contamination:

1 Septic tank 2 Sewer lines 3 Watertight sewer lines 4 Lateral lines 5 Cess pool 6 Seepage pit 7 Pit privy 8 Sewage lagoon 9 Feedyard 10 Livestock pens 11 Fuel storage 12 Fertilizer storage 13 Insecticide storage ~~14 Abandoned water well~~ 15 Oil well/Gas well 16 Other (specify below)

Direction from well? South How many feet? 15

FROM	TO	LITHOLOGIC LOG	FROM	TO	PLUGGING INTERVALS
0	2	Topsoil			
2	26	Brown Clay			
26	44	(Med) Sand			
44	50	Limestone + Grey Shale			

7 CONTRACTOR'S OR LANDOWNER'S CERTIFICATION: This water well was (1) constructed, (2) reconstructed, or (3) plugged under my jurisdiction and was completed on (mo/day/year) June 24 88 and this record is true to the best of my knowledge and belief. Kansas Water Well Contractor's License No. 234 This Water Well Record was completed on (mo/day/yr) Sept. 5 88 under the business name of Blue Valley Drilling by (signature) Eric Funk

INSTRUCTIONS: Use typewriter or ball point pen. *PLEASE PRESS FIRMLY* and *PRINT* clearly. Please fill in blanks, underline or circle the correct answers. Send top three copies to Kansas Department of Health and Environment, Bureau of Water Protection, Topeka, Kansas 66620-7320. Telephone: 913-296-5514. Send one to WATER WELL OWNER and retain one for your records.

OFFICE USE ONLY