


1 LOCATION OF WATER WELL: Fraction SW 1/4 SW SE 1/4 Section Number 26 Township Number T 2 S Range Number R 5 E/W
 County: Washington
 Distance and direction from nearest town or city street address of well or located within city?
From Washington, 12 1/2 miles east on US 36 Hwy on north side

2 WATER WELL OWNER: Vincent Bruna
 RR#, St. Address, Box # 300 E N. Hanover Kans 66945 Board of Agriculture, Division of Water Resources
 City, State, ZIP Code Application Number:

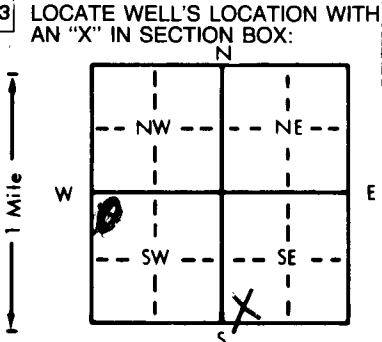

4 DEPTH OF COMPLETED WELL 119 ft. ELEVATION:
 Depth(s) Groundwater Encountered 110 ft. 2. ft. 3. ft.
 WELL'S STATIC WATER LEVEL 90 ft. below land surface measured on mo/day/yr aug 9 - 85
 Pump test data: Well water was ft. after hours pumping gpm
 Est. Yield 30 gpm: Well water was ft. after hours pumping gpm
 Bore Hole Diameter 10 in. to 20 ft., and 6 1/2 in. to 119 ft.
 WELL WATER TO BE USED AS:
 1 Domestic 3 Feedlot 6 Oil field water supply 9 Dewatering 12 Other (Specify below)
 2 Irrigation 4 Industrial 7 Lawn and garden only 10 Observation well
 Was a chemical/bacteriological sample submitted to Department? Yes.....No X.....; If yes, mo/day/yr sample was sub-
 mitted Water Well Disinfected? Yes X No

5 TYPE OF BLANK CASING USED:
 1 Steel 3 RMP (SR) 5 Wrought iron 8 Concrete tile CASING JOINTS: Glued X Clamped
 2 PVC 4 ABS 6 Asbestos-Cement 9 Other (specify below) Welded
 Blank casing diameter 5 1/2 in. to 80 ft., Dia. 5 in. to 119 ft., Dia. 40' Perf on lower end
 Casing height above land surface 12 in., weight 200 P.S.L. lbs./ft. Wall thickness or gauge No. 267 wall
 TYPE OF SCREEN OR PERFORATION MATERIAL:
 1 Steel 3 Stainless steel 5 Fiberglass 7 PVC 10 Asbestos-cement
 2 Brass 4 Galvanized steel 6 Concrete tile 9 ABS 11 Other (specify)
 12 None used (open hole)
 SCREEN OR PERFORATION OPENINGS ARE:
 1 Continuous slot 3 Mill slot 5 Gauzed wrapped 8 Saw cut 11 None (open hole)
 2 Louvered shutter 4 Key punched 6 Wire wrapped 9 Drilled holes
 7 Torch cut 10 Other (specify)
 SCREEN-PERFORATED INTERVALS: From 119 ft. to 80 ft., From ft. to ft.
 From ft. to ft., From ft. to ft.
 GRAVEL PACK INTERVALS: From 119 ft. to 20 ft., From ft. to ft.
 From ft. to ft., From ft. to ft.

6 GROUT MATERIAL: 1 Neat cement 2 Cement grout 3 Bentonite 4 Other
 Grout Intervals: From 20 ft. to 8 ft., From ft. to ft., From ft. to ft.
 What is the nearest source of possible contamination:
 1 Septic tank 4 Lateral lines 7 Pit privy 10 Livestock pens 14 Abandoned water well
 2 Sewer lines 5 Cess pool 8 Sewage lagoon 11 Fuel storage 15 Oil well/Gas well
 3 Watertight sewer lines 6 Seepage pit 9 Feedyard 12 Fertilizer storage 16 Other (specify below)
 13 Insecticide storage 160 g lot
 Direction from well? north How many feet? 150

FROM	TO	LITHOLOGIC LOG	FROM	TO	LITHOLOGIC LOG
0	3	TOP SOIL			
3	30	clay yellow			
30	38	clay + blue mixed			
38	70	Rock yellow limestone			
70	90	Shale blue			
90	107	Shale Red			
107	115	Rock Limestone + Water 30 g, P.M.			
115	119	Shale Blue			

7 CONTRACTOR'S OR LANDOWNER'S CERTIFICATION: This water well was (1) constructed, (2) reconstructed, or (3) plugged under my jurisdiction and was completed on (mo/day/year) aug 7 - 1985 and this record is true to the best of my knowledge and belief. Kansas Water Well Contractor's License No. 237 This Water Well Record was completed on (mo/day/yr) aug 10 - 85 under the business name of Strader Drilling Co by (signature) Harold Strader
 INSTRUCTIONS: Use typewriter or ball point pen, PLEASE PRESS FIRMLY and PRINT clearly. Please fill in blanks, underline or circle the correct answers. Send top three copies to Kansas Department of Health and Environment, Division of Environment, Environmental Geology Section, Topeka, KS 66620. Send one to WATER WELL OWNER and retain one for your records.