


1 LOCATION OF WATER WELL:	Fraction	Section Number	Township Number	Range Number
County: <u>Washington</u>	<u>NW NW 1/4 NE 1/4</u>	<u>34</u>	<u>T 2 S</u>	<u>R 5 E/W</u>

Distance and direction from nearest town or city street address of well if located within city?  
Pony Express truck stop - Jct IIS 36 & K148, Hanover, Kansas

2 WATER WELL OWNER: Farmers Co-op Elevator Assoc.  
 RR#, St. Address, Box #: P. O. Box 303  
 City, State, ZIP Code: Hanover, Kansas 66945  
 Board of Agriculture, Division of Water Resources  
 Application Number:

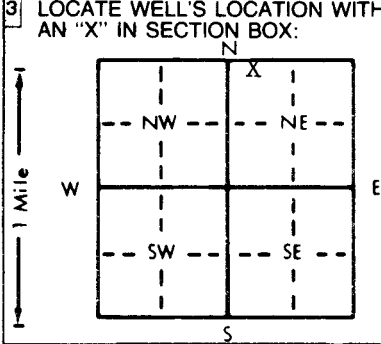

4 DEPTH OF COMPLETED WELL: 20 ft. ELEVATION: 1352.8 - SL  
 Depth(s) Groundwater Encountered 1. Dry ft. 2. ft. 3. ft.  
 WELL'S STATIC WATER LEVEL 11.08 ft. below land surface measured on mo/day/yr 2/23/91  
 Pump test data: Well water was ft. after hours pumping gpm  
 Est. Yield gpm: Well water was ft. after hours pumping gpm  
 Bore Hole Diameter: 6 in. to 20' ft., and in. to ft.  
 WELL WATER TO BE USED AS:  
 5 Public water supply 8 Air conditioning 11 Injection well  
 1 Domestic 3 Feedlot 6 Oil field water supply 9 Dewatering 12 Other (Specify below)  
 2 Irrigation 4 Industrial 7 Lawn and garden only 10 Monitoring well  
 Was a chemical/bacteriological sample submitted to Department? Yes. No. X; If yes, mo/day/yr sample was submitted  
 Water Well Disinfected? Yes No X

5 TYPE OF BLANK CASING USED:  
 1 Steel 3 RMP (SR) 5 Wrought iron 8 Concrete tile CASING JOINTS: Glued Clamped  
 2 PVC 4 ABS 6 Asbestos-Cement 9 Other (specify below) Welded  
 7 Fiberglass Threaded X  
 Blank casing diameter 2 in. to 10 ft., Dia in. to ft., Dia in. to ft.  
 Casing height above land surface 2.91 FT weight lbs./ft. Wall thickness or gauge No.  
 TYPE OF SCREEN OR PERFORATION MATERIAL:  
 1 Steel 3 Stainless steel 5 Fiberglass 7 PVC 10 Asbestos-cement  
 2 Brass 4 Galvanized steel 6 Concrete tile 8 RMP (SR) 11 Other (specify)  
 9 ABS 12 None used (open hole)  
 SCREEN OR PERFORATION OPENINGS ARE:  
 1 Continuous slot 3 Mill slot 5 Gauzed wrapped 8 Saw cut 11 None (open hole)  
 2 Louvered shutter 4 Key punched 6 Wire wrapped 9 Drilled holes  
 7 Torch cut 10 Other (specify)  
 SCREEN-PERFORATED INTERVALS: From 10 ft. to 19 ft. From ft. to ft.  
 From ft. to ft. From ft. to ft.  
 GRAVEL PACK INTERVALS: From 8.7 ft. to 20 ft. From ft. to ft.  
 From ft. to ft. From ft. to ft.

6 GROUT MATERIAL: 1 Neat cement 2 Cement grout 3 Bentonite 4 Other  
 Grout Intervals: From #2 0 ft. to 6.7 ft. From #3 6.7 ft. to 8.7 ft. From ft. to ft.  
 What is the nearest source of possible contamination:  
 1 Septic tank 4 Lateral lines 7 Pit privy 10 Livestock pens 14 Abandoned water well  
 2 Sewer lines 5 Cess pool 8 Sewage lagoon 11 Fuel storage 15 Oil well/Gas well  
 3 Watertight sewer lines 6 Seepage pit 9 Feedyard 12 Fertilizer storage 16 Other (specify below)  
 13 Insecticide storage  
 Direction from well? E How many feet? 600'

FROM	TO	LITHOLOGIC LOG	FROM	TO	PLUGGING INTERVALS
0	4.0	Brown Lean clay with gravel, Brownish orange, lean to fat clay			
4.0	6.0	Brownish orange lean to fat clay orangish yellow fat clay			
6.0	8.0	Yellowish green moist clay, lean			
8.0	10.4	Highly weathered limestone, light brown green weathered shale			
10.4	12.2	light brown grey wheathered shale			
12.2	15.0	Weathered limestone stringers, fat clay			
15.0	21.1	Maroon Shale			

7 CONTRACTOR'S OR LANDOWNER'S CERTIFICATION: This water well was (1) constructed, (2) reconstructed, or (3) plugged under my jurisdiction and was completed on (mo/day/year) 1/28/91 and this record is true to the best of my knowledge and belief. Kansas Water Well Contractor's License No. 416. This Water Well Record was completed on (mo/day/yr) 3/7/91  
 under the business name of Terracon by (signature) [Signature]