


1	LOCATION OF WATER WELL: County: <u>Marshall</u>	Fraction <u>SW 1/4 SW 1/4 SW 1/4</u>	Section Number <u>9</u>	Township Number <u>2</u>	Range Number <u>6</u>
---	--	---	----------------------------	-----------------------------	--------------------------

Distance and direction from nearest town or city street address of well if located within city?  
Bremen is 1 mi West and 1/2 m. North

2 WATER WELL OWNER: Harold Travelute  
 RR#, St. Address, Box #: 2498 Spruce Hvy.  
 City, State, ZIP Code: Hanover KS 66945  
 Board of Agriculture, Division of Water Resources  
 Application Number:

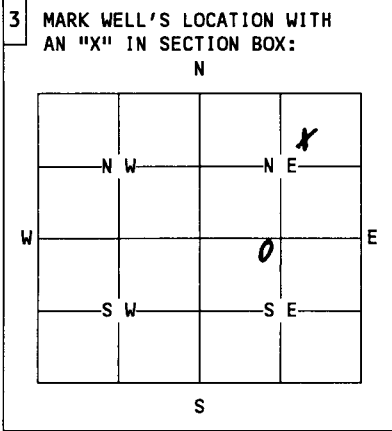

4 DEPTH OF WELL.....29.....ft.  
 WELL'S STATIC WATER LEVEL.....20.....ft. to H<sub>2</sub>O  
 WELL WAS USED AS:  
 1 Domestic      5 Public Water Supply      9 Dewatering  
 2 Irrigation    6 Oil Field Water Supply    10 Monitoring Well  
 3 Feedlot       7 Lawn and Garden Only      11 Injection Well  
 4 Industrial    8 Air Conditioning            12 Other pasture livestock  
 Was a chemical/bacteriological sample submitted to Department? Yes....No...  
 If yes, mo/day/yr sample was submitted.....  
 Water Well Disinfected: Yes... No.....

5 TYPE OF BLANK CASING USED:  
 1 Steel    3 RMP (SR)    5 Wrought    7 Fiberglass    9 Other (specify below)  
 2 PVC     4 ABS         6 Asbestos-Cement    8 Concrete Tile    10 Rock lined  
 Blank casing diameter.....42.....in.    Was casing pulled? Yes... No..... If yes, how much 5'  
 Casing height above or below land surface.....60.....in.

6 GROUT PLUG MATERIAL: 1 Neat cement    2 Cement grout    3 Bentonite    4 Other.....  
 Grout Plug Intervals: From 4.5 ft. to 50 ft., From.....ft. to .....ft., From..... to.....ft.  
 What is the nearest source of possible contamination:  
 1 Septic tank                      6 Seepage pit                      11 Fuel storage                      16 Other (specify below)  
 2 Sewer lines                      7 Pit privy                          12 Fertilizer storage  
 3 Watertight sewer lines       8 Sewage lagoon                  13 Insecticide storage  
 4 Lateral lines                      9 Feedyard                          14 Abandoned water well  
 5 Cess Pool                          10 Livestock pens                  15 Oil well/Gas well  
 Direction from well? SW                      How many feet? 1/4 mile

FROM	TO	PLUGGING MATERIALS
<u>0</u>	<u>4.5</u>	<u>Topsoil</u>
<u>4.5</u>	<u>5.0</u>	<u>Bentonite Plug Grade</u>
<u>5.0</u>	<u>20.0</u>	<u>Clay Soil</u>
<u>20</u>	<u>29</u>	<u>Chlorinated Sand</u>

7 CONTRACTOR'S OR LANDOWNER'S CERTIFICATION: This water well was plugged under my jurisdiction and was completed on (mo/day/year) 09/14/95 and this record is true to the best of my knowledge and belief. Kansas Water Well Contractor's License No. landowner This Water Well Record was completed on (mo/day/year) 09/11/95 under the business name of Marshall Co. Conservation District by (signature) mpilene Stamm, WQ Coordinator

INSTRUCTIONS: Use typewriter or ball point pen. Please press firmly and print clearly. Please fill in blanks, underline or circle the correct answers. Send top three copies to Kansas Department of Health and Environment, Bureau of Water, Topeka, Kansas 66620-0001. Telephone: 913/296-3565. Send one to Water Well Owner and retain one for your records.