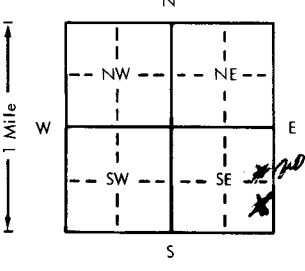


USE TYPEWRITER OR BALL
POINT PEN-PRESS FIRMLY,
PRINT CLEARLY.

WATER WELL RECORD
KSA 82a-1201-1215

Kansas Department of Health and
Environment-Division of Environment
(Water well Contractors)
Topeka, Kansas 66620

1. Location of well:		County Marshall	Fraction SE 1/4 SE SE 1/4	Section number 21	Township number T 2 S	Range number R 6 E/W
2. Distance and direction from nearest town or city: Street address of well location if in city:			3. Owner of well: Mike Wilson R.R. or street: R.R. City, state, zip code: Marysville, Kans. 66508			
4. Locate with "X" in section below: N W E S 1 Mile			Sketch map: 			
5. Type and color of material			From	To	6. Bore hole dia. 8 in. Completion date 4-16-79 Well depth 135 ft.	
Silt			0	2	7. <input checked="" type="checkbox"/> Cable tool <input checked="" type="checkbox"/> Rotary <input type="checkbox"/> Driven <input type="checkbox"/> Dug <input type="checkbox"/> Hollow rod <input type="checkbox"/> Jetted <input type="checkbox"/> Bored <input type="checkbox"/> Reverse rotary	
clay			2	19	8. Use: <input checked="" type="checkbox"/> Domestic <input type="checkbox"/> Public supply <input type="checkbox"/> Industry <input type="checkbox"/> Irrigation <input type="checkbox"/> Air conditioning <input type="checkbox"/> Stock <input type="checkbox"/> Lawn <input type="checkbox"/> Oil field water <input type="checkbox"/> Other	
lime soft			19	30	<input checked="" type="checkbox"/> Casing: Material PVC Weight: Above or below Threaded <input type="checkbox"/> Welded <input type="checkbox"/> Surface 12 in. RMP <input type="checkbox"/> PVC Weight 200 lbs./ft. Dia. 5 in. to 135 ft. depth <input checked="" type="checkbox"/> Wall Thickness: inches or Dia. <input type="checkbox"/> in. to <input type="checkbox"/> ft. depth Gauge No. 200	
shale blue + gray			30	46	<input checked="" type="checkbox"/> Screen: Manufacturer's name Plastics KSF approved # 300 Type Plastic Dia. 5 1/2 Slot/gauze .060 Length 2 1/2 Set between 111 ft. and 135 ft. Gravel pack yes Size range of material C 4 X 1	
limestone			46	47	11. Static water level: 85 ft. below land surface Date 4-16-79	
shale tan			47	50	12. Pumping level below land surfaces: ____ ft. after ____ hrs. pumping ____ g.p.m. ____ ft. after ____ hrs. pumping ____ g.p.m. Estimated maximum yield ____ g.p.m.	
shale red			50	67	13. Water sample submitted: ____ mo./day/yr. Yes <input checked="" type="checkbox"/> No <input type="checkbox"/> Date ____	
shale tan			67	78	<input checked="" type="checkbox"/> Well head completion: capped ____ Pitless adapter ____ Inches above grade	
shale blue			78	106	15. Well grouted? yes With: ____ Neat cement ____ Bentonite <input checked="" type="checkbox"/> Concrete Depth: From 0 ft. to 20 ft.	
shale brown			106	114	16. Nearest source of possible contamination: none ft. ____ Direction ____ Type ____ Well disinfected upon completion? <input checked="" type="checkbox"/> Yes ____ No	
shale gray			114	117	17. Pump: <input checked="" type="checkbox"/> Not installed Manufacturer's name ____ Model number ____ HP ____ Volts ____ Length of drop pipe ____ ft. capacity ____ g.p.m. Type: ____ Submersible ____ Turbine ____ Jet ____ Reciprocating ____ Centrifugal ____ Other	
shale brown			117	120	20. Water well contractor's certification: This well was drilled under my jurisdiction and this report is true to the best of my knowledge and belief. Blue Valley Drill License No. 7340 Business name Blue Rapids License No. 66411 Address 4444 1/2 Signed Harold Thaler Date 5-14-79 Authorized representative	
shale gray			120	125		
shale red			125	135		
(Use a second sheet if needed)						
18. Elevation:		19. Remarks:		20. Water well contractor's certification:		
Topography: <input checked="" type="checkbox"/> Hill <input type="checkbox"/> Slope <input type="checkbox"/> Upland <input type="checkbox"/> Valley						