

USE TYPEWRITER OR BALL POINT PEN-PRESS FIRMLY, PRINT CLEARLY.

2 8 E 3 0 S E S E W
T R EW sec 1/4 1/4 1/4 No.


WATER WELL RECORD
KSA 82a-1201-1215

Kansas State Dept. Of Health
(Water Well Contractors)
Forbes-Bldg. 740
Topeka, Kansas 66620

SESESE

1 Location of well: County Marshall Franklin Township name SESESE Fraction 30²⁵ Section number T 25 Town number R 2 E 7 Range number

Distance and direction from nearest town or city: 1/2 E of Marysville 3 Owner of well: Perd Uering
Street address of well location if in city: Marysville Address: Marysville Kansas

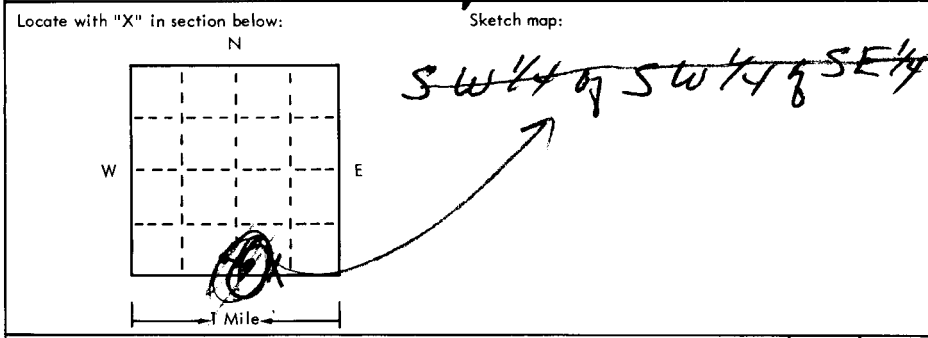

4 Well depth: 100 ft. Date of completion 9/25/75
Well diameter 6 1/2 in.

5 Cable tool Rotary Driven Dug
 Hollow rod Jetted Bored Reverse rotary

6 Use: Domestic Public supply Industry
 Irrigation Air conditioning Commercial
 Test well

7 Casing: Material PVC Height: above/ below
Threaded Welded Surface 24 in.
Diam. 10 in. to 20 ft. depth Drive shoe? Yes No
6 1/2 in. to 100 ft. depth!

2	Type and color of material	From	To
	top soil	0	1
	Brown clay	1	14
	sandy clay	14	17
	limestone rock layers	17	22
	white clay soft	22	26
	yellow rock layers (limestone)	26	34
	Red shale	34	48
	Water yellow & white rock layers	48	59
	Blue shale & lime rock	59	90
	Flint Rock layers	90	102

8 Screen: Manufacturer James
Type slotted Dia. 5
Slot/groove 0.60 Length 50
Set between 47-67 and 82-102
Fittings: Gravel pack Yes No Size range of material 1/8

9 Static water level: 46 ft. below land surface Date 9/25/75

10 Pumping level below land surfaces:
____ ft. after ____ hrs. pumping ____ g.p.m.
____ ft. after ____ hrs. pumping ____ g.p.m.
Estimated maximum yield 10 g.p.m.

11 Water sample submitted:
 Yes No Date _____

12 Well head completion:
 Pitless adapter Inches above grade

13 Well grouted? Yes No
 Neat cement Bentonite _____
Depth: From 0 ft. to 20 ft.

14 Nearest source of possible contamination:
ft. 100 Direction W Type septic tank
Well disinfected upon completion? Yes No

15 Pump: Not installed
Manufacturer's name _____
Model number _____ HP _____ Volts _____
Length of drop pipe _____ ft. capacity _____ g.p.m.
Type:
 Submersible Turbine
 Jet Reciprocating
 Centrifugal Other

16 Remarks: elevation 1280
Topography:
 Hill
 Slope
 Upland
 Valley

17 Water well contractor's certification:
This well was drilled under my jurisdiction and this report is true to the best of my knowledge and belief.
Blue Valley Rully 234
Business name License No.
Address Blue Rapids KS
Signed David [Signature] Date 9/25/75
Authorized representative