


USE TYPEWRITER OR BALL POINT PEN-PRESS FIRMLY, PRINT CLEARLY.

WATER WELL RECORD
KSA 82a-1201-1215

Kansas Department of Health and Environment-Division of Environment (Water well Contractors) Topeka, Kansas 66620

1. Location of well: County MARSHALL Fraction SE 1/4 NE 1/4 NE 1/4 Section number 28 Township number T 2 S R 7 EAW Range number

2. Distance and direction from nearest town or city: IN Marysville City 3. Owner of well: GEORGE MUSIL
Street address of well location if in city: 915-CH 13TH ST. Former street: 915-CH 13TH-Block 4
City, state, zip code: Marysville Ks

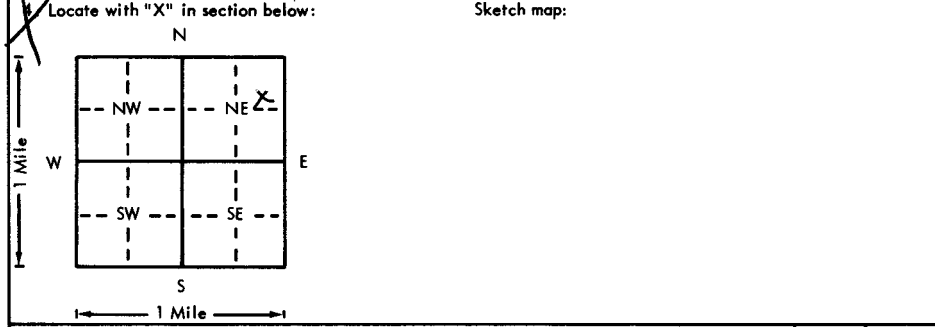

6. Bore hole dia. 8 in. Completion date 6-17-76
Well depth 60 ft.
7. Cable tool Rotary Driven Dug
 Hollow rod Jetted Bored Reverse rotary
8. Use: Domestic Public supply Industry
 Irrigation Air conditioning Stock
 Lawn Oil field water Other
9. Casing: Material PST Height: Above or below
Threaded Welded 9L Surface 7 1/4 in.
RMP PVC Weight 255 lbs./ft.
Dia. 5 in. to 60 ft. depth Wall Thickness: inches or
Dia. 5 in. to 60 ft. depth gage No. 280

5. Type and color of material	From	To
<u>Clay, BROWN</u>	<u>0</u>	<u>20</u>
<u>LIME Rock, white</u>	<u>20</u>	<u>25</u>
<u>Clay, white</u>	<u>25</u>	<u>30</u>
<u>Clay, white + layers Lime Rock, w</u>	<u>30</u>	<u>35</u>
<u>Lime Rock, white</u>	<u>35</u>	<u>40</u>
<u>Clay, Blue</u>	<u>40</u>	<u>45</u>
<u>Lime Rock, white</u>	<u>45</u>	<u>50</u>
<u>LIME Rock, gray</u>	<u>50</u>	<u>55</u>
<u>Shale, Blue</u>	<u>55</u>	<u>60</u>
(Use a second sheet if needed)		

10. Screen: Manufacturer's name Slotted by Driller
Type PVC Dia. 5 in.
Slot/gauze 1/6 Length 30'
Set between 30 ft. and 60 ft.
ft. and 60 ft.
Gravel pack? YES size range of material 1/6 - 1/2
11. Static water level: 28 mo./day/yr.
28 ft. below land surface Date 6-17-76
12. Pumping level below land surfaces:
 ft. after hrs. pumping g.p.m.
 ft. after hrs. pumping g.p.m.
Estimated maximum yield g.p.m.
13. Water sample submitted: mo./day/yr.
Yes No Date
14. Well head completion:
 Pitless adapter 16 inches above grade
15. Well grouted? yes
With: Neat cement Bentonite Concrete
Depth: From 4 ft. to 15 ft.
16. Nearest source of possible contamination:
ft. W Direction 50' Type City Sewer
Well disinfected upon completion? Yes No
17. Pump: Not installed
Manufacturer's name
Model number HP Volts
Length of drop pipe ft. capacity g.p.m.
Type:
 Submersible Turbine
 Jet Reciprocating
 Centrifugal Other

18. Elevation: Topography: Hill Slope Upland Valley

19. Remarks:

20. Water well contractor's certification:
This well was drilled under my jurisdiction and this report is true to the best of my knowledge and belief.
Harper Drilling Service 176
Business name Blue Springs Ks. License No.
Address
Signed T. E. Harper Date 6-17-76
Authorized representative

T-2
R-7
W-1
S-28
SE NE NE