


1 LOCATION OF WATER WELL: County: Marshall Fraction: NW 1/4 NE 1/4 SE 1/4 Section Number: 26 Township Number: T 2 S Range Number: R 7 E

Distance and direction from nearest town or city street address of well if located within city? 2 E Marysville

2 WATER WELL OWNER: East Side Water District
 RR#, St. Address, Box #: Rt. 3 Marysville, Kansas 66508
 City, State, ZIP Code: Box A
 Board of Agriculture, Division of Water Resources
 Application Number:

3 LOCATE WELL'S LOCATION WITH AN "X" IN SECTION BOX:

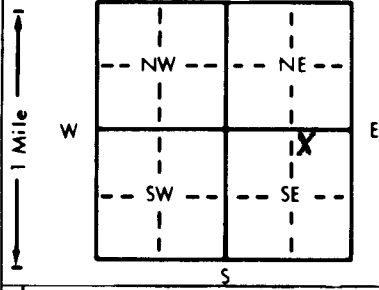

4 DEPTH OF COMPLETED WELL: 95 ft. ELEVATION:

Depth(s) Groundwater Encountered 1. ft. 2. ft. 3. ft.
 WELL'S STATIC WATER LEVEL ... 38 ... ft. below land surface measured on mo/day/yr 4/11/91
 Pump test data: Well water was 28 ft. after 20 hours pumping gpm
 Est. Yield ... 50 gpm: Well water was 33 ft. after 36 hours pumping gpm
 Bore Hole Diameter: ... 9 in. to ... 9.5 in. to in. to ft.
 WELL WATER TO BE USED AS:
 5 Public water supply 8 Air conditioning 11 Injection well
 1 Domestic 3 Feedlot 6 Oil field water supply 9 Dewatering 12 Other (Specify below)
 2 Irrigation 4 Industrial 7 Lawn and garden only 10 Monitoring well
 Was a chemical/bacteriological sample submitted to Department? Yes No ; If yes, mo/day/yr sample was submitted
 Water Well Disinfected? Yes No

5 TYPE OF BLANK CASING USED: 5 Wrought iron 8 Concrete tile CASING JOINTS: Glued Clamped
 1 Steel 3 RMP (SR) 6 Asbestos-Cement 9 Other (specify below) Welded
2 PVC 4 ABS 7 Fiberglass Threaded

Blank casing diameter: ... 5 in. to ... 7.5 ft., Dia in. to ft., Dia in. to ft.
 Casing height above land surface: ... 18 in., weight ... 200 lbs./ft. Wall thickness or gauge No.

TYPE OF SCREEN OR PERFORATION MATERIAL:
 1 Steel 3 Stainless steel 5 Fiberglass 8 RMP (SR) 10 Asbestos-cement
 2 Brass 4 Galvanized steel 6 Concrete tile 9 ABS 11 Other (specify)
 12 None used (open hole)

SCREEN OR PERFORATION OPENINGS ARE:
1 Continuous slot 3 Mill slot 5 Gauzed wrapped 8 Saw cut 11 None (open hole)
 2 Louvered shutter 4 Key punched 6 Wire wrapped 9 Drilled holes
 7 Torch cut 10 Other (specify)

SCREEN-PERFORATED INTERVALS: From: ... 7.5 ft. to ... 9.5 ft., From ft. to ft.
 From: ft. to ft., From ft. to ft.
 GRAVEL PACK INTERVALS: From: ... 20 ft. to ... 95 ft., From ft. to ft.
 From ft. to ft., From ft. to ft.

6 GROUT MATERIAL: 1 Neat cement 2 Cement grout 3 Bentonite 4 Other

Grout Intervals: From ft. to ft., From ft. to ft., From ft. to ft.
 What is the nearest source of possible contamination:
 1 Septic tank 4 Lateral lines 7 Pit privy 10 Livestock pens 14 Abandoned water well
 2 Sewer lines 5 Cess pool 8 Sewage lagoon 11 Fuel storage 15 Oil well/Gas well
 3 Watertight sewer lines 6 Seepage pit 9 Feedyard 12 Fertilizer storage 16 Other (specify below)
 13 Insecticide storage Sand Pit

Direction from well? 800 How many feet? SE

FROM	TO	LITHOLOGIC LOG	FROM	TO	PLUGGING INTERVALS
0	4	Topsoil			
4	11	Brown Clay			
11	22	Brown Clay + Fine Sand			
22	80	Fine White Sand			
80	89	Coarse Gravel Fine - Med Fine Yellow Sand			
89	91	Coarse Gravel			
91	93	Lime stone			
93	95	Gray Shale			

7 CONTRACTOR'S OR LANDOWNER'S CERTIFICATION: This water well was (1) constructed, (2) reconstructed, or (3) plugged under my jurisdiction and was completed on (mo/day/year) ... 4/11/91 ... and this record is true to the best of my knowledge and belief. Kansas Water Well Contractor's License No. ... 518 ... This Water Well Record was completed on (mo/day/yr) ... 4/11/91 ... under the business name of Blue Valley Drilling by (signature) Eric Stank