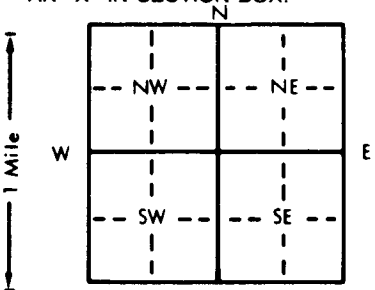


**WATER WELL RECORD Form WWC-5 KSA 82a-1212**

1 LOCATION OF WATER WELL: County: <u>Marshall</u>	Fraction <u>SE 1/4 NW 1/4 NW 1/4</u>	Section Number <u>28</u>	Township Number <u>T 2 S</u>	Range Number <u>R 7 E</u>
--	---	-----------------------------	---------------------------------	------------------------------

Distance and direction from nearest town or city street address of well if located within city?  
4,200' North and 4,400' West of the Southeast Corner of said section.

2 WATER WELL OWNER: <u>City of Marysville</u> RR#, St. Address, Box # : <u>209 North Eighth Street</u> City, State, ZIP Code : <u>Marysville, KS 66508-1699</u>	Also known as Well #7 Board of Agriculture, Division of Water Resources Application Number: <u>18,565</u>
---	---

3 LOCATE WELL'S LOCATION WITH AN "X" IN SECTION BOX: 	4 DEPTH OF COMPLETED WELL: <u>42</u> ft. ELEVATION: Depth(s) Groundwater Encountered <u>1</u> ft. 2. ft. 3. ft. WELL'S STATIC WATER LEVEL <u>25</u> ft. below land surface measured on mo/day/yr Pump test data: Well water was _____ ft. after _____ hours pumping _____ gpm Est. Yield _____ gpm: Well water was _____ ft. after _____ hours pumping _____ gpm Bore Hole Diameter _____ in. to _____ ft., and _____ in. to _____ ft. WELL WATER TO BE USED AS: <input checked="" type="radio"/> Public water supply    8 Air conditioning    11 Injection well 1 Domestic    3 Feedlot    6 Oil field water supply    9 Dewatering    12 Other (Specify below) 2 Irrigation    4 Industrial    7 Lawn and garden only    10 Monitoring well Was a chemical/bacteriological sample submitted to Department? Yes _____ No <input checked="" type="checkbox"/> If yes, mo/day/yr sample was submitted _____ Water Well Disinfected? Yes <input checked="" type="checkbox"/> No _____
--	---

5 TYPE OF BLANK CASING USED: 1 <u>Steel</u> 3 RMP (SR) 2 PVC    4 ABS	5 Wrought iron 6 Asbestos-Cement 7 Fiberglass	8 Concrete tile 9 Other (specify below)	CASING JOINTS: Glued _____ Clamped _____ Welded _____ Threaded _____
Blank casing diameter <u>12</u> in. to _____ ft., Dia _____ in. to _____ ft., Dia _____ in. to _____ ft. Casing height above land surface <u>48</u> in., weight _____ lbs./ft. Wall thickness or gauge No. _____	TYPE OF SCREEN OR PERFORATION MATERIAL: 1 <u>Steel</u> 3 Stainless steel    5 Fiberglass    8 RMP (SR)    11 Other (specify) _____ 2 Brass    4 Galvanized steel    6 Concrete tile    9 ABS    12 None used (open hole)		
SCREEN OR PERFORATION OPENINGS ARE: 1 <u>Continuous-slot</u> 3 Mill slot 2 Louvered shutter    4 Key punched	5 Gauzed wrapped 6 Wire wrapped Torch cut	8 Saw cut 9 Drilled holes 10 Other (specify) _____	11 None (open hole)
SCREEN-PERFORATED INTERVALS: From <u>42</u> ft. to <u>17</u> ft., From _____ ft. to _____ ft. GRAVEL PACK INTERVALS: From <u>42</u> ft. to <u>17</u> ft., From _____ ft. to _____ ft.			

6 GROUT MATERIAL: 1 Neat cement    2 <u>Cement grout</u> 3 Bentonite    4 Other _____	Grout Intervals: From <u>7</u> ft. to <u>4</u> ft., From _____ ft. to _____ ft., From _____ ft. to _____ ft.
What is the nearest source of possible contamination: 1 Septic tank    4 Lateral lines    7 Pit privy 2 Sewer lines    5 Cess pool    8 Sewage lagoon 3 Watertight sewer lines    6 Seepage pit    9 Feedyard	10 Livestock pens    14 Abandoned water well 11 Fuel storage    15 Oil well/Gas well 12 Fertilizer storage    16 Other (specify below) 13 Insecticide storage
Direction from well? _____	How many feet? <u>300</u> <b>RIVER POND YARD</b>

FROM	TO	LITHOLOGIC LOG	FROM	TO	PLUGGING INTERVALS
			<u>42</u>	<u>25</u>	<u>SAND</u>
			<u>25</u>	<u>7</u>	<u>CLAY</u>
			<u>7</u>	<u>4</u>	<u>CEMENT</u>
			<u>4</u>	<u>0</u>	<u>CLAY</u>

7 CONTRACTOR'S OR LANDOWNER'S CERTIFICATION: This water well was <u>(1) constructed, (2) reconstructed, or (3) plugged</u> under my jurisdiction and was completed on (mo/day/year) <u>October 11, 1991</u> and this record is true to the best of my knowledge and belief. Kansas Water Well Contractor's License No. <u>NA</u> This Water Well Record was completed on (mo/day/yr) <u>November 19, 1991</u> under the business name of <u>City of Marysville, KS</u> by (signature) <u>Paula Valle, City Clerk</u>
--