


1 LOCATION OF WATER WELL: County: Marshall Fraction: NE 1/4 NE 1/4 1/4 Section Number: 30 Township Number: T 2S S Range Number: R 7 EW  
 Distance and direction from nearest town or city street address of well if located within city? 1/2 W 1/4 N 1/4 W 1/8 N of Marysville  
A 2.50 ac. tr. of land in the NE 1/4 of NE 1/4 Sec. 30-T2S-R7E; beg. at a point on the E. line of Sec. 30 which is 769' S of the NE cor, thence W 295.16', thence S 220.12', thence E 295.16', thence N along Board of Agriculture, Division of Water Resources  
 2 WATER WELL OWNER: Joe Ellenbecker RR#, St. Address, Box #: Marysville, KS 66508 City, State, ZIP Code: Marysville, KS 66508 Application Number: 3-13-84

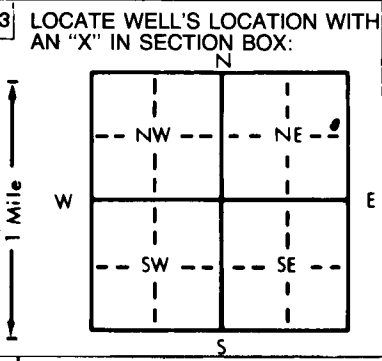

4 DEPTH OF COMPLETED WELL: 82 ft. ELEVATION: 82 ft.  
 WELL WATER TO BE USED AS:  
 1 Domestic X 3 Feedlot 6 Oil field water supply 9 Dewatering 12 Other (Specify below)  
 2 Irrigation 4 Industrial 7 Lawn and garden only 10 Observation well  
 Was a chemical/bacteriological sample submitted to Department? Yes X No X; If yes, mo/day/yr sample was submitted X  
 Water Well Disinfected? Yes X No X

5 TYPE OF BLANK CASING USED:  
 1 Steel 3 RMP (SR) 5 Wrought iron 8 Concrete tile CASING JOINTS: Glued X Clamped X  
 2 PVC 4 ABS 6 Asbestos-Cement 9 Other (specify below) Welded X  
 7 Fiberglass Threaded X  
 TYPE OF SCREEN OR PERFORATION MATERIAL:  
 1 Steel 3 Stainless steel 5 Fiberglass 7 PVC 10 Asbestos-cement  
 2 Brass 4 Galvanized steel 6 Concrete tile 8 RMP (SR) 11 Other (specify)  
 9 ABS 12 None used (open hole)  
 SCREEN OR PERFORATION OPENINGS ARE:  
 1 Continuous slot 3 Mill slot 5 Gauzed wrapped 8 Saw cut 11 None (open hole)  
 2 Louvered shutter 4 Key punched 6 Wire wrapped 9 Drilled holes  
 7 Torch cut 10 Other (specify)  

 What is the nearest source of possible contamination:  
 1 Septic tank 4 Lateral lines 7 Pit privy 10 Livestock pens 14 Abandoned water well  
 2 Sewer lines 5 Cess pool 8 Sewage lagoon 11 Fuel storage 15 Oil well/Gas well  
 3 Watertight sewer lines 6 Seepage pit 9 Feedyard 12 Fertilizer storage 16 Other (specify below)  
 13 Insecticide storage  
 Direction from well? W How many feet? 100

FROM	TO	LITHOLOGIC LOG	FROM	TO	LITHOLOGIC LOG
0	2	Top Soil			
2	13	Red Clay			
13	28	Yellow Clay			
28	40	Red Clay			
40	48	Loose Lime & Clay			
48	82	Blue Shale			

7 CONTRACTOR'S OR LANDOWNER'S CERTIFICATION: This water well was (1) constructed, (2) reconstructed, or (3) plugged under my jurisdiction and was completed on (mo/day/year) 3-13-84 and this record is true to the best of my knowledge and belief. Kansas Water Well Contractor's License No. 234 This Water Well Record was completed on (mo/day/yr) 5-25-84 under the business name of Blue Valley Drilling by (signature) David Stuck  
 INSTRUCTIONS: Use typewriter or ball point pen, PLEASE PRESS FIRMLY and PRINT clearly. Please fill in blanks, underline or circle the correct answers. Send top three copies to Kansas Department of Health and Environment, Division of Environment, Environmental Geology Section, Topeka, KS 66620. Send one to WATER WELL OWNER and retain one for your records.