


1] LOCATION OF WATER WELL: County: Marshall Fraction: NE 1/4 NE 1/4 NW 1/4 Section Number: 33 Township Number: T 2 S Range Number: R 7 EW

Distance and direction from nearest town or city street address of well if located within city?
617 Broadway, Marysville

2] WATER WELL OWNER: City of Marysville
RR#, St. Address, Box #: 209 N. 8th. Board of Agriculture, Division of Water Resources
City, State, ZIP Code: Marysville, KS Application Number:

3] LOCATE WELL'S LOCATION WITH AN "X" IN SECTION BOX:

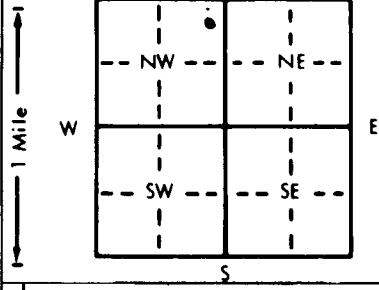

4] DEPTH OF COMPLETED WELL: 25ft. ft. ELEVATION:

Depth(s) Groundwater Encountered: 1. 16ft. ft. 2. ft. 3. ft.
WELL'S STATIC WATER LEVEL: 11ft. ft. below land surface measured on mo/day/yr 8-17-93
Pump test data: Well water was ft. after hours pumping gpm
Est. Yield: +2 gpm: Well water was ft. after hours pumping gpm
Bore Hole Diameter: 7 1/2" in. to 2 5/8" ft., and in. to ft.
WELL WATER TO BE USED AS:
1 Domestic 3 Feedlot 6 Oil field water supply 9 Dewatering 12 Other (Specify below)
2 Irrigation 4 Industrial 7 Lawn and garden only 10 Monitoring well
Was a chemical/bacteriological sample submitted to Department? Yes No X; If yes, mo/day/yr sample was submitted
Water Well Disinfected? Yes No

5] TYPE OF BLANK CASING USED:
1 Steel 3 RMP (SR) 5 Wrought iron 8 Concrete tile CASING JOINTS: Glued Clamped
2 PVC 4 ABS 6 Asbestos-Cement 9 Other (specify below) Welded
7 Fiberglass Threaded X

Blank casing diameter: 2.42 in. to 15ft. ft., Dia. in. to ft., Dia. in. to ft.
Casing height above land surface: Flush Mount in., weight lbs./ft. Wall thickness or gauge No. SOL-13 Sch 40

TYPE OF SCREEN OR PERFORATION MATERIAL:
1 Steel 3 Stainless steel 5 Fiberglass 8 RMP (SR) 10 Asbestos-cement
2 Brass 4 Galvanized steel 6 Concrete tile 9 ABS 11 Other (specify)
12 None used (open hole)

SCREEN OR PERFORATION OPENINGS ARE:
1 Continuous slot 3 Mill slot 1.00 5 Gauzed wrapped 8 Saw cut 11 None (open hole)
2 Louvered shutter 4 Key punched 6 Wire wrapped 9 Drilled holes
7 Torch cut 10 Other (specify)

SCREEN-PERFORATED INTERVALS: From 25' ft. to 15' ft., From ft. to ft.
From ft. to ft., From ft. to ft.
GRAVEL PACK INTERVALS: From 25' ft. to 13' ft., From ft. to ft.
From ft. to ft., From ft. to ft.

6] GROUT MATERIAL: 1 Neat cement 2 Cement grout 3 Bentonite 4 Other
Grout Intervals: From 13' ft. to 4' ft., From 4' ft. to 0' ft., From ft. to ft.

What is the nearest source of possible contamination:
1 Septic tank 4 Lateral lines 7 Pit privy 10 Livestock pens 14 Abandoned water well
2 Sewer lines 5 Cess pool 8 Sewage lagoon 11 Fuel storage 15 Oil well/Gas well
3 Watertight sewer lines 6 Seepage pit 9 Feedyard 12 Fertilizer storage 16 Other (specify below)
13 Insecticide storage

Direction from well? North How many feet? 100ft

FROM	TO	LITHOLOGIC LOG	FROM	TO	PLUGGING INTERVALS
0	1.2	Quartzite Gravel			
1.2	8.0	Black silty clay, moist			
8.0	19.5	Med. Brown clay, silty clay, iron oxides			
19.5	21.0	Brown sandy silts to sandy clay, fine-med. grained			
21.0	25.0	Tan fine-very coarse grained sand subangular & sub rounded			

7] CONTRACTOR'S OR LANDOWNER'S CERTIFICATION: This water well was (1 constructed, 2 reconstructed, or 3) plugged under my jurisdiction and was completed on (mo/day/year) 8-17-93 and this record is true to the best of my knowledge and belief. Kansas Water Well Contractor's License No. 539 This Water Well Record was completed on (mo/day/yr) 8-18-93 under the business name of G Environmental Drilling by (signature) James Becker