


1 LOCATION OF WATER WELL: County: Marshall Fraction: NE 1/4 NE 1/4 NW 1/4 Section Number: 33 Township Number: T 2 S Range Number: R 7 EW

Distance and direction from nearest town or city street address of well if located within city?
617 Broadway - Marysville

2 WATER WELL OWNER: City of Marysville
 RR#, St. Address, Box #: 209 N. 8th.
 City, State, ZIP Code: Marysville, Ks. 66508
 Board of Agriculture, Division of Water Resources
 Application Number:

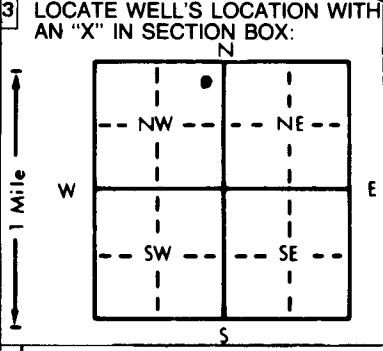

4 DEPTH OF COMPLETED WELL: 25ft ft. ELEVATION:
 Depth(s) Groundwater Encountered 1. 19 ft. 2. ft. 3. ft.
 WELL'S STATIC WATER LEVEL 11ft ft. below land surface measured on mo/day/yr 8-17-93
 Pump test data: Well water was ft. after hours pumping gpm
 Est. Yield 1.2 gpm: Well water was ft. after hours pumping gpm
 Bore Hole Diameter: 7 1/2" in. to 25ft ft., and in. to ft.
 WELL WATER TO BE USED AS:
 5 Public water supply 8 Air conditioning 11 Injection well
 1 Domestic 3 Feedlot 6 Oil field water supply 9 Dewatering 12 Other (Specify below)
 2 Irrigation 4 Industrial 7 Lawn and garden only 10 Monitoring well
 Was a chemical/bacteriological sample submitted to Department? Yes No X; If yes, mo/day/yr sample was submitted
 Water Well Disinfected? Yes No

5 TYPE OF BLANK CASING USED:
 1 Steel 3 RMP (SR) 5 Wrought iron 8 Concrete tile CASING JOINTS: Glued Clamped
2 PVC 4 ABS 6 Asbestos-Cement 9 Other (specify below) Welded
 7 Fiberglass Threaded X
 Blank casing diameter 2.42 in. to 15' ft., Dia. in. to ft., Dia. in. to ft.
 Casing height above land surface Flush Mount in., weight lbs./ft. Wall thickness or gauge No. SDR-13
 TYPE OF SCREEN OR PERFORATION MATERIAL:
 1 Steel 3 Stainless steel 5 Fiberglass 7 PVC 10 Asbestos-cement Sch 40
 2 Brass 4 Galvanized steel 6 Concrete tile 8 RMP (SR) 11 Other (specify)
 12 None used (open hole)
 SCREEN OR PERFORATION OPENINGS ARE:
 1 Continuous slot 3 Mill slot .010 5 Gauzed wrapped 8 Saw cut 11 None (open hole)
 2 Louvered shutter 4 Key punched 6 Wire wrapped 9 Drilled holes
 7 Torch cut 10 Other (specify)
 SCREEN-PERFORATED INTERVALS: From 25' ft. to 15' ft., From ft. to ft.
 From ft. to ft., From ft. to ft.
 GRAVEL PACK INTERVALS: From 25' ft. to 14' ft., From ft. to ft.
 From ft. to ft., From ft. to ft.

6 GROUT MATERIAL: 1 Neat cement 2 Cement grout 3 Bentonite 4 Other
 Grout Intervals: From 14' ft. to 4' ft., From 4' ft. to Surface ft., From ft. to ft.
 What is the nearest source of possible contamination:
 1 Septic tank 4 Lateral lines 7 Pit privy 11 Fuel storage 14 Abandoned water well
 2 Sewer lines 5 Cess pool 8 Sewage lagoon 12 Fertilizer storage 15 Oil well/Gas well
 3 Watertight sewer lines 6 Seepage pit 9 Feedyard 13 Insecticide storage 16 Other (specify below)
 Direction from well? North How many feet? 5ft.

FROM	TO	LITHOLOGIC LOG	FROM	TO	PLUGGING INTERVALS
0	5.0	Sand & gravel base			
5.0	7.50	DK Brown - Black silty clay			
7.50	10.75	Light Brown - Olive Gray silty clay			
10.75	19.25	Olive Brown to Gray Brown clay			
19.25	21.0	Med Brown silty sandy clay, fine grained sand			
21.0	25.0	Pale Green sand, fine-very coarse sub angular & sub rounded grains			

7 CONTRACTOR'S OR LANDOWNER'S CERTIFICATION: This water well was (1) constructed, (2) reconstructed, or (3) plugged under my jurisdiction and was completed on (mo/day/year) 8-17-93 and this record is true to the best of my knowledge and belief. Kansas Water Well Contractor's License No. 539 This Water Well Record was completed on (mo/day/yr) 8-18-93 under the business name of G.B. Environmental Drilling by (signature) James Coker

INSTRUCTIONS: Use typewriter or ball point pen. PLEASE PRESS FIRMLY and PRINT clearly. Please fill in blanks, underline or circle the correct answers. Send top three copies to Kansas Department of Health and Environment, Bureau of Water, Topeka, Kansas 66620-0001. Telephone: 913-296-5545. Send one to WATER WELL OWNER and retain one for your records.