

1 LOCATION OF WATER WELL:	Fraction	Section Number	Township Number	Range Number
County: Marshall	NE 1/4 NE 1/4 NW 1/4	33	T 2 S	R 7 <u>EW</u>

Distance and direction from nearest town or city street address of well if located within city?


617 Broadway, Marysville

2 WATER WELL OWNER: **City of Marysville**

RR#, St. Address, Box # : **209 North 8th** Board of Agriculture, Division of Water Resources

City, State, ZIP Code : **Marysville, Kansas 66508** Application Number:

3 LOCATE WELL'S LOCATION WITH AN "X" IN SECTION BOX:

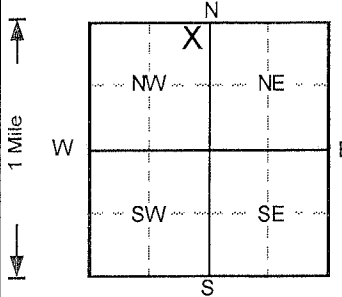

4 DEPTH OF COMPLETED WELL **30** ft. ELEVATION: **1155.73**

Depth(s) Groundwater Encountered 1. ft. 2. ft. 3. ft.

WELL'S STATIC WATER LEVEL ft. below land surface measured on mo/day/yr

Pump test data: Well water was **NA** ft. after hours pumping gpm

Est. Yield .. **NA** .. gpm: Well water was ft. after hours pumping gpm

Bore Hole Diameter **8** in. to **30** ft., and in. to ft.

WELL WATER TO BE USED AS:

5 Public water supply	8 Air conditioning	11 Injection well
1 Domestic	3 Feedlot	6 Oil field water supply
2 Irrigation	4 Industrial	7 Lawn and garden only
		10 Monitoring well
12 Other (Specify below)		

Was a chemical/bacteriological sample submitted to Department? Yes No ; If yes, mo/day/yr sample was submitted

Water Well Disinfected? Yes No

5 TYPE OF BLANK CASING USED:

1 Steel	3 RMP (SR)	6 Asbestos-Cement	9 Other (specify below)	CASING JOINTS: Glued Clamped
2 PVC	4 ABS	7 Fiberglass		Welded

Blank casing diameter **2** in. to **15** ft., Dia in. to ft., Dia in. to ft.

Casing height above land surface **-6.6** in., weight lbs./ft. Wall thickness or gauge No. **Sch. 40**

TYPE OF SCREEN OR PERFORATION MATERIAL

1 Steel	3 Stainless steel	5 Fiberglass	7 PVC	10 Asbestos-cement
2 Brass	4 Galvanized steel	6 Concrete tile	9 ABS	11 Other (specify)
12 None used (open hole)				

SCREEN OR PERFORATION OPENINGS ARE:

1 Continuous slot	3 Mill slot	5 Gauzed wrapped	8 Saw cut	11 None (open hole)
2 Louvered shutter	4 Key punched	6 Wire wrapped	9 Drilled holes	
7 Torch cut				
10 Other (specify)				

SCREEN-PERFORATED INTERVALS: From **15** ft. to **30** ft., From ft. to ft.

GRAVEL PACK INTERVALS: From **13** ft. to **30** ft., From ft. to ft.

6 GROUT MATERIAL: 1 Neat cement 2 Cement grout **3** Bentonite **4** Other **Concrete**

Grout Intervals: From **0** ft. to **1.5** ft., From **1.5** ft. to **15** ft., From ft. to ft.

What is the nearest source of possible contamination:

1 Septic tank	4 Lateral lines	7 Pit privy	10 Livestock pens	14 Abandoned water well
2 Sewer lines	5 Cess pool	8 Sewage lagoon	11 Fuel storage	15 Oil well/Gas well
3 Watertight sewer lines	6 Seepage pit	9 Feedyard	12 Fertilizer storage	16 Other (specify below)
			13 Insecticide storage	

Direction from well? How many feet?

FROM	TO	LITHOLOGIC LOG	FROM	TO	PLUGGING INTERVALS
0	0.5	Gravel,			
0.5	1.5	Soil,			
1.5	8	Sand, vf-c (fill), Lt. Brown			
8	12.5	Sand, silty to v. silty, Dark Brown			
12.5	19	Clay, Gray to Blue Gray			
19	21	Clay, sandy, Dark Gray			
21	24	Sand, vf-c, silty, Gray			
24	30	Sand, vf-c, Gray Green			
					MW3R, Flushmount

7 CONTRACTOR'S OR LANDOWNER'S CERTIFICATION: This water well was **(1)** constructed, (2) reconstructed, or (3) plugged under my jurisdiction and was completed on (mo/day/year) **4/26/2013** and this record is true to the best of my knowledge and belief.

Kansas Water Well Contractor's License No. **527** This Water Well Record was completed on (mo/day/yr) **5/24/13**

under the business name of **GeoCore, Inc.** by (signature) *Dale Kelly*