

**WATER WELL PLUGGING RECORD Form WWC-5P KSA 82a-1212 ID NO.**

Not Registered


**1 LOCATION OF WATER WELL:** County: Marshall Fraction: ¼ NE ¼ SW ¼ NW ¼ Section Number: 28 Township Number: T 2 S Range Number: 7  E  W

Street/Rural Address of Well Location; if unknown, distance & direction from nearest town or intersection: If at owner's address, check here  North Street & North 5th Street, Marysville  
  
MW-16

**Global Positioning Systems (GPS) information:**  
Latitude: 39.851676 (in decimal degrees)  
Longitude: -96.653187 (in decimal degrees)  
Elevation: 1154.04  
Horizontal Datum:  WGS84,  NAD83,  NAD27  
Collection Method:

**2 WATER WELL OWNER:** Union Pacific Railroad  
RR#, St. Address, Box #: 1416 Dodge Street  
City, State ZIP Code: Omaha, NE 68179

GPS unit (Make/Model: \_\_\_\_\_)  
 Digital Map/Photo,  Topographic Map,  Land Survey  
Est. Accuracy:  < 3 m,  3-5 m,  5-15 m,  > 15 m

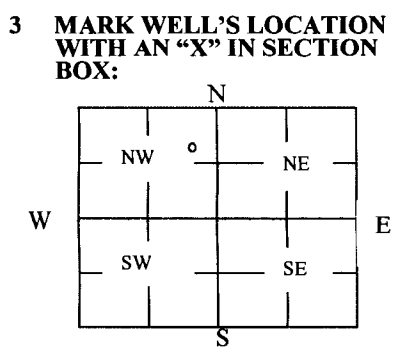

**4 DEPTH OF WELL** 22.5 ft.  
WELL'S STATIC WATER LEVEL 16 ft.  
WELL WAS USED AS:  
 Domestic  Public Water Supply  Dewatering  
 Irrigation  Oil Field Water Supply  Monitoring  
 Feedlot  Domestic (Lawn & Garden)  Injection Well  
 Industrial  Air Conditioning  Other \_\_\_\_\_  
Was a chemical/bacteriological sample submitted to Department? Yes  No

**5 TYPE OF BLANK CASING USED:**  
 Steel  RMP (SR)  Wrought  Fiberglass  Other (Specify below) \_\_\_\_\_  
 PVC  ABS  Asbestos-Cement  Concrete Tile  
Blank casing diameter 2 in. Was casing pulled? Yes  No  If yes, how much 4 feet  
Casing height above or below land surface -48 in.

**6 GROUT PLUG MATERIAL:**  Neat cement  Cement grout  Bentonite  Other \_\_\_\_\_  
Grout Plug Intervals: From 0 ft. to 22.5 ft., From \_\_\_\_\_ ft. to \_\_\_\_\_ ft., From \_\_\_\_\_ ft. to \_\_\_\_\_ ft.  
What is the nearest source of possible contamination:  
 Septic tank  Seepage pit  Fuel storage  Other (specify below) LUST Site  
 Sewer lines  Pit privy  Fertilizer storage  
 Watertight sewer lines  Sewage lagoon  Insecticide storage  
 Lateral lines  Feedyard  Abandoned water well Direction from well? Site  
 Cess pool  Livestock pens  Oil well/Gas well How many feet? 0

FROM	TO	PLUGGING MATERIALS	FROM	TO	PLUGGING MATERIALS
0	22.5	WyoBen Medium Chips			

**7 CONTRACTOR'S OR LANDOWNER'S CERTIFICATION:** This water well was plugged under my jurisdiction and was completed on (mo/day/year) 09/04/2019 and this record is true to the best of my knowledge and belief. Kansas Water Well Contractor's License No. 616. This Water Well Record was completed on (mo/day/year) 09/04/2019 under the business name of Thiele Geotech, Inc. by (signature) Robert Miller  
Digitally signed by Robert Miller Date: 2019.09.04 15:17:50 -0500

Send one white copy to Kansas Department of Health & Environment, Geology Section, 1000 SW Jackson Street, Ste. 420, Topeka, KS 66612-1367. Send one copy to WATER WELL OWNER and retain one for your records.  
Visit us at <http://www.kdheks.gov/waterwell/index.html> Telephone 785-296-5524.