

WATER WELL PLUGGING RECORD Form WWC-5P KSA 82a-1212 ID NO.

350278

1 LOCATION OF WATER WELL: County: Marshall	Fraction ¼ SE ¼ SW ¼ NW ¼	Section Number 28	Township Number T 2 S	Range Number 7 <input checked="" type="checkbox"/> E <input type="checkbox"/> W
---	-------------------------------------	-----------------------------	---------------------------------	---


Street/Rural Address of Well Location; if unknown, distance & direction from nearest town or intersection: If at owner's address, check here **North Street & North 5th Street, Marysville**

MW-1

Global Positioning Systems (GPS) information:
Latitude: **39.851451** (in decimal degrees)
Longitude: **-96.653427** (in decimal degrees)
Elevation: **1153.13**
Horizontal Datum: WGS84, NAD83, NAD27
Collection Method:

2 WATER WELL OWNER: Union Pacific Railroad
RR#, St. Address, Box #: **1416 Dodge Street**
City, State ZIP Code: **Omaha, NE 68179**

GPS unit (Make/Model: _____)
 Digital Map/Photo, Topographic Map, Land Survey
Est. Accuracy: < 3 m, 3-5 m, 5-15 m, > 15 m

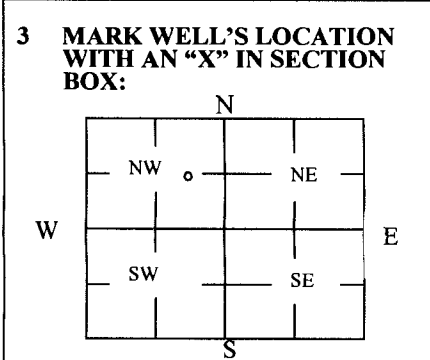

4 DEPTH OF WELL 25 **ft.**
WELL'S STATIC WATER LEVEL 16 **ft**
WELL WAS USED AS:
 Domestic Public Water Supply Dewatering
 Irrigation Oil Field Water Supply Monitoring
 Feedlot Domestic (Lawn & Garden) Injection Well
 Industrial Air Conditioning Other _____
 Was a chemical/bacteriological sample submitted to Department? Yes No

5 TYPE OF BLANK CASING USED:

Steel RMP (SR) Wrought Fiberglass Other (Specify below) _____
 PVC ABS Asbestos-Cement Concrete Tile

Blank casing diameter 2 in. Was casing pulled? Yes No If yes, how much 25 feet
 Casing height above or below land surface NA in.

6 GROUT PLUG MATERIAL: Neat cement Cement grout Bentonite Other _____

Grout Plug Intervals: From 0 ft. to 25 ft., From _____ ft. to _____ ft., From _____ ft. to _____ ft.

What is the nearest source of possible contamination:
 Septic tank Seepage pit Fuel storage Other (specify below) _____
 Sewer lines Pit privy Fertilizer storage **LUST Site**
 Watertight sewer lines Sewage lagoon Insecticide storage
 Lateral lines Feedyard Abandoned water well Direction from well? Site
 Cess pool Livestock pens Oil well/Gas well How many feet? 0

FROM	TO	PLUGGING MATERIALS	FROM	TO	PLUGGING MATERIALS
0	25	WyoBen Medium Chips			

7 CONTRACTOR'S OR LANDOWNER'S CERTIFICATION: This water well was plugged under my jurisdiction and was completed on (mo/day/year) 09/04/2019 and this record is true to the best of my knowledge and belief. Kansas Water Well Contractor's License No. 616. This Water Well Record was completed on (mo/day/year) 09/04/2019 under the business name of Thiele Geotech, Inc. by (signature) Robert Miller

Digitally signed by Robert Miller
Date: 2019.09.04 15:00:51 -0500

Send one white copy to Kansas Department of Health & Environment, Geology Section, 1000 SW Jackson Street, Ste. 420, Topeka, KS 66612-1367. Send one copy to WATER WELL OWNER and retain one for your records.
 Visit us at <http://www.kdheks.gov/waterwell/index.html> Telephone 785-296-5524.