

WATER WELL RECORD Form WWC-5


Division of Water Resources App. No.

Well ID

Original Record Correction Change in Well Use

1 LOCATION OF WATER WELL: County: MARSHALL Fraction SW 1/4 SE 1/4 SE 1/4 SE 1/4 Section Number 10 Township Number T 5 S Range Number R 9 E W

2 WELL OWNER: Last Name: Business: R L RANCH & CATTLE COMP. Address: 14016 FONTANA STREET City: OVERLAND PARK State: KS ZIP: 66224 Street or Rural Address where well is located...

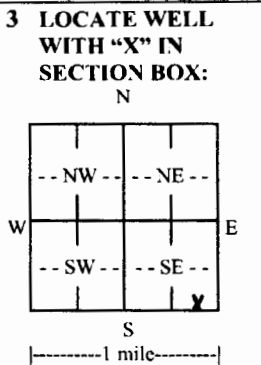

4 DEPTH OF COMPLETED WELL: 41 ft. Depth(s) Groundwater Encountered: 1) ... ft. 2) ... ft. 3) ... ft. or 4) Dry Well WELL'S STATIC WATER LEVEL: 9 ft. below land surface, measured on (mo-day-yr) 7/15/2022

5 Latitude: 39-37-29.70N Longitude: 96-23-29.40W Horizontal Datum: WGS 84 Source for Latitude/Longitude: GPS

6 Elevation: ... ft. Source: Land Survey GPS Topographic Map Other

7 WELL WATER TO BE USED AS: 1. Domestic 2. Irrigation 3. Feedlot 4. Industrial 5. Public Water Supply 6. Dewatering 7. Aquifer Recharge 8. Monitoring 9. Environmental Remediation 10. Oil Field Water Supply 11. Test Hole 12. Geothermal 13. Other

Was a chemical/bacteriological sample submitted to KDHE? Water well disinfected?

8 TYPE OF CASING USED: Steel PVC Other CASING JOINTS: Glued Clamped Welded Threaded Casing diameter 5 in. to 11 ft. Diameter 5 in. to 11 ft. Diameter 5 in. to 11 ft. Casing height above land surface 18 in. Weight 2.8 lbs./ft. Wall thickness or gauge No. 265

9 GROUT MATERIAL: Neat cement Cement grout Bentonite Other Grout Intervals: From 0 ft. to 10 ft.

Nearest source of possible contamination: Septic Tank Lateral Lines Pit Privy Livestock Pens Insecticide Storage Sewer Lines Cess Pool Sewage Lagoon Fuel Storage Abandoned Water Well Watertight Sewer Lines Seepage Pit Feedyard Fertilizer Storage Oil Well/Gas Well Other (Specify)

Table with columns: FROM, TO, LITHOLOGIC LOG, FROM, TO, LITHO. LOG (cont.) or PLUGGING INTERVALS. Rows: 0-7 BROWN CLAY, 7-8 GRANTED ROCK, 8-11 BROWN CLAY, 11-16 LIMESTONE, 16-23 GRAY SHALE, 23-36 LIMESTONE, 36-41 GRAY SHALE

11 CONTRACTOR'S OR LANDOWNER'S CERTIFICATION: This water well was constructed, reconstructed, or plugged under my jurisdiction and was completed on (mo-day-year) 7/15/2022...