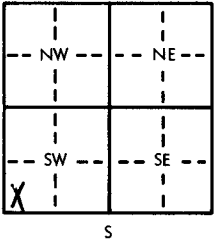
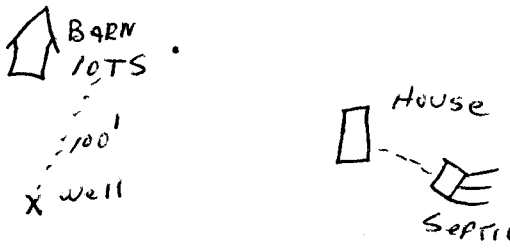


USE TYPEWRITER OR BALL POINT PEN-PRESS FIRMLY, PRINT CLEARLY.

WATER WELL RECORD  
KSA 82a-1201-1215

Kansas Department of Health and Environment-Division of Environment (Water well Contractors) Topeka, Kansas 66620

1. Location of well:	County <b>MARSHAL</b>	Fraction <b>SW 1/4 SW 1/4 SW 1/4</b>	Section number <b>29</b>	Township number <b>T 2 S</b>	Range number <b>R 9 E/W</b>
2. Distance and direction from nearest town or city: <b>1.5 mi W</b> Street address of well location if in city: <b>Beattie, KS</b>			3. Owner of well: <b>Alfred Rombeck</b> R.R. or street: <b>Beattie, KS</b> City, state, zip code:		
4. Locate with "X" in section below:  Sketch map: 			6. Bore hole dia. <b>8</b> in. Completion date <b>9-21-76</b> Well depth <b>120</b> ft.		
			7. Cable tool <input checked="" type="checkbox"/> Rotary <input type="checkbox"/> Driven <input type="checkbox"/> Dug <input type="checkbox"/> Hollow rod <input type="checkbox"/> Jetted <input type="checkbox"/> Bored <input type="checkbox"/> Reverse rotary		
			8. Use: <input checked="" type="checkbox"/> Domestic <input type="checkbox"/> Public supply <input type="checkbox"/> Industry <input type="checkbox"/> Irrigation <input type="checkbox"/> Air conditioning <input type="checkbox"/> Stock <input type="checkbox"/> Lawn <input type="checkbox"/> Oil field water <input type="checkbox"/> Other		
			9. Casing: Material <b>PVC</b> Height: <b>Above or below</b> Threaded <input type="checkbox"/> Welded <input type="checkbox"/> Surface <b>29</b> in. RMP <b>PVC 9L</b> Weight <b>2.58</b> lbs./ft. Dia. <b>5</b> in. to <b>120</b> ft. depth Wall Thickness: inches or Dia. <input type="checkbox"/> in. to <input type="checkbox"/> ft. depth gage No. <b>224 258</b>		
5. Type and color of material			10. Screen: Manufacturer's name <b>Pumpco</b> Type <b>PVC</b> Dia. <b>5</b> Gauge <b>.020</b> Length <b>20</b> Set between <b>40</b> ft. and <b>60</b> ft. Gravel pack? <input checked="" type="checkbox"/> Size range of material <b>.030 X .060</b>		
			11. Static water level: <b>50</b> ft. below land surface Date <b>9-21-76</b> mo./day/yr.		
			12. Pumping level below land surfaces: ft. after ___ hrs. pumping ___ g.p.m. ft. after ___ hrs. pumping ___ g.p.m. Estimated maximum yield <b>5</b> g.p.m.		
			13. Water sample submitted: ___ Yes <input checked="" type="checkbox"/> No Date ___ mo./day/yr.		
			14. Well head completion: <b>CAP</b> <input type="checkbox"/> Pitless adapter <b>24</b> inches above grade		
			15. Well grouted? <input checked="" type="checkbox"/> With: <input checked="" type="checkbox"/> Neat cement <input type="checkbox"/> Bentonite <input type="checkbox"/> Concrete Depth: From <b>3</b> ft. to <b>15</b> ft.		
			16. Nearest source of possible contamination: ft. <b>100</b> Direction <b>N</b> Type <b>LOTS</b> Well disinfected upon completion? <input checked="" type="checkbox"/> Yes <input type="checkbox"/> No		
			17. Pump: <input checked="" type="checkbox"/> Not installed Manufacturer's name ___ HP ___ Volts ___ Length of drop pipe ___ ft. capacity ___ g.p.m. Type: ___ Submersible ___ Turbine ___ Jet ___ Reciprocating ___ Centrifugal ___ Other		
(Use a second sheet if needed)					
18. Elevation:  Topography: <input checked="" type="checkbox"/> Hill <input type="checkbox"/> Slope <input type="checkbox"/> Upland <input type="checkbox"/> Valley		19. Remarks:  <b>owner will instal slab</b>			
		20. Water well contractor's certification: This well was drilled under my jurisdiction and this report is true to the best of my knowledge and belief. <b>Starter Dalg Co Inc 182</b> Business name License No. ___ Address <b>RT 1 Holton, KS</b> Signed <b>Dale Patman</b> Date <b>9-27-76</b> Authorized representative			

T-2  
 R-9  
 W-E  
 Sec 29  
 1/4 1/4  
 S.W. 1/4