


1 LOCATION OF WATER WELL: County: Sumner Fraction: NE 1/4 NW 1/4 NW 1/4 Section Number: 10 Township Number: T 30 S Range Number: R 1 EW

Distance and direction from nearest town or city street address of well if located within city?
3 3/4 miles west and 1 mile south

2 WATER WELL OWNER: Mr and Mrs Robert Young
 RR#, St. Address, Box #: RR1 (New Residence)
 City, State, ZIP Code: Mulvane Kansas 67110
 Board of Agriculture, Division of Water Resources
 Application Number: _____

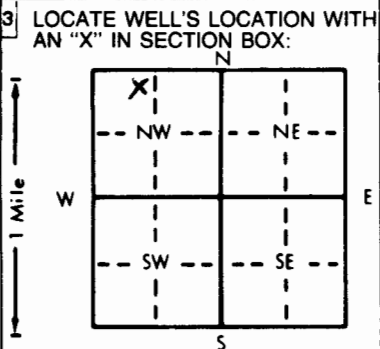

4 DEPTH OF COMPLETED WELL: 34 ft. ELEVATION: ?
 Depth(s) Groundwater Encountered 1. 13 ft. 2. _____ ft. 3. _____ ft.
 WELL'S STATIC WATER LEVEL 4 ft. below land surface measured on mo/day/yr _____
 Pump test data: Well water was 15 ft. after 1 hours pumping 1.0 1/2 gpm
 Est. Yield 11 1/2 gpm: Well water was _____ ft. after _____ hours pumping _____ gpm
 Bore Hole Diameter 9 in. to _____ ft., and _____ in. to _____ ft.
 WELL WATER TO BE USED AS:
 5 Public water supply 8 Air conditioning 11 Injection well
 1 Domestic 3 Feedlot 6 Oil field water supply 9 Dewatering 12 Other (Specify below)
 2 Irrigation 4 Industrial 7 Lawn and garden only 10 Monitoring well _____
 Was a chemical/bacteriological sample submitted to Department? Yes (No); If yes, mo/day/yr sample was submitted _____
 Water Well Disinfected? Yes No

5 TYPE OF BLANK CASING USED:
 1 Steel 2 PVC 3 RMP (SR) 4 ABS
 5 Wrought iron 6 Asbestos-Cement 7 Fiberglass
 8 Concrete tile 9 Other (specify below)
 CASING JOINTS: Glued Clamped _____
 Welded _____
 Threaded _____
 Blank casing diameter 5 in. to 6 ft., Dia _____ in. to _____ ft., Dia _____ in. to _____ ft.
 Casing height above land surface 24 in., weight _____ lbs./ft. Wall thickness or gauge No. _____
 TYPE OF SCREEN OR PERFORATION MATERIAL:
 1 Steel 3 Stainless steel 5 Fiberglass 7 PVC 10 Asbestos-cement
 2 Brass 4 Galvanized steel 6 Concrete tile 8 RMP (SR) 11 Other (specify) _____
 12 None used (open hole)
 SCREEN OR PERFORATION OPENINGS ARE:
 1 Continuous slot 3 Mill slot 5 Gauzed wrapped 8 Saw cut 11 None (open hole)
 2 Louvered shutter 4 Key punched 6 Wire wrapped 9 Drilled holes
 7 Torch cut 10 Other (specify) _____
 SCREEN-PERFORATED INTERVALS: From 6 ft. to 34 ft., From _____ ft. to _____ ft.
 From _____ ft. to _____ ft., From _____ ft. to _____ ft.
 GRAVEL PACK INTERVALS: From 6 ft. to 34 ft., From _____ ft. to _____ ft.
 From _____ ft. to _____ ft., From _____ ft. to _____ ft.

6 GROUT MATERIAL: 1 Neat cement 2 Cement grout 3 Bentonite 4 Other _____
 Grout Intervals: From 0 ft. to 6 ft., From _____ ft. to _____ ft., From _____ ft. to _____ ft.
 What is the nearest source of possible contamination:
 1 Septic tank 4 Lateral lines 7 Pit privy 10 Livestock pens 14 Abandoned water well
 2 Sewer lines 5 Cess pool 8 Sewage lagoon 11 Fuel storage 15 Oil well/Gas well
 3 Watertight sewer lines 6 Seepage pit 9 Feedyard 12 Fertilizer storage 16 Other (specify below)
 13 Insecticide storage
 Direction from well? West How many feet? 55' to House

FROM	TO	LITHOLOGIC LOG	FROM	TO	PLUGGING INTERVALS
		Well #1			
0	3'	Red-brown soil			
3	6'	red-brown silty and sandy soil			
6	16'	fine quartz sand, some gravel			
16	25'	gray, green gray and red-brown clays			
25'	30'	green-gray clay - sandy.			
30	34'	gray-black clay			

7 CONTRACTOR'S OR LANDOWNER'S CERTIFICATION: This water well was (1) constructed, (2) reconstructed, or (3) plugged under my jurisdiction and was completed on (mo/day/year) 01-20-96 and this record is true to the best of my knowledge and belief. Kansas Water Well Contractor's License No. 579 This Water Well Record was completed on (mo/day/yr) 01-29-96 under the business name of Stable Well Drilling and Services by (signature) William J. Hobbs