


1 LOCATION OF WATER WELL: Fraction NE 1/4 NW 1/4 NW 1/4 Section Number 10 Township Number T 30 S Range Number R 1 EW  
 County: Sumner

Distance and direction from nearest town or city street address of well if located within city?  
3 3/4 miles West and 1 mile South

2 WATER WELL OWNER: Mr and Mrs Robert Young  
 RR#, St. Address, Box #: RR1 (New Residence) Board of Agriculture, Division of Water Resources  
 City, State, ZIP Code: Mulvane, Kansas 67110 Application Number:

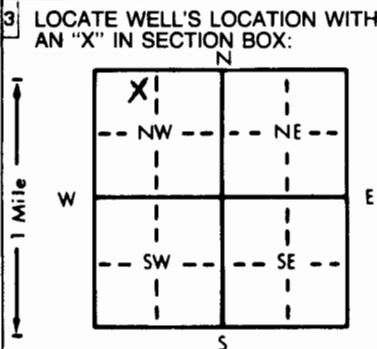

4 DEPTH OF COMPLETED WELL: 19 1/2 ft. ELEVATION: ?  
 Depth(s) Groundwater Encountered 1. 13 ft. 2. 15 ft. 3. 10 1/2 ft.  
 WELL'S STATIC WATER LEVEL 2 1/2 ft. below land surface measured on mo/day/yr Jan 28, 1996  
 Pump test data: Well water was 15 ft. after 1 hours pumping 10 1/2 gpm  
 Est. Yield 11 1/2 gpm: Well water was 15 ft. after 1 hours pumping 10 1/2 gpm  
 Bore Hole Diameter: 9 in. to 9 in. to 9 in. to 9 in.  
 WELL WATER TO BE USED AS:  
 1 Domestic  3 Feedlot  6 Oil field water supply  9 Dewatering  12 Other (Specify below)  
 2 Irrigation  4 Industrial  7 Lawn and garden only  10 Monitoring well  
 Was a chemical/bacteriological sample submitted to Department? Yes No If yes, mo/day/yr sample was submitted  
 Water Well Disinfected? Yes No

5 TYPE OF BLANK CASING USED:  
 1 Steel  3 RMP (SR)  6 Asbestos-Cement  9 Other (specify below)  Welded  
 2 PVC  4 ABS  7 Fiberglass  Threaded  
 Casing height above land surface 24 in., weight 24 lbs./ft. Wall thickness or gauge No. 24  
 TYPE OF SCREEN OR PERFORATION MATERIAL:  
 1 Steel  3 Stainless steel  5 Fiberglass  7 PVC  10 Asbestos-cement  
 2 Brass  4 Galvanized steel  6 Concrete tile  9 ABS  11 Other (specify)  12 None used (open hole)  
 SCREEN OR PERFORATION OPENINGS ARE:  
 1 Continuous slot  3 Mill slot  5 Gauzed wrapped  8 Saw cut  11 None (open hole)  
 2 Louvered shutter  4 Key punched  6 Wire wrapped  9 Drilled holes  
 7 Torch cut  10 Other (specify)  
 SCREEN-PERFORATED INTERVALS: From 6 ft. to 16 1/2 ft., From 6 ft. to 16 1/2 ft., From 6 ft. to 16 1/2 ft., From 6 ft. to 16 1/2 ft.  
 GRAVEL PACK INTERVALS: From 6 ft. to 19 1/2 ft., From 6 ft. to 19 1/2 ft., From 6 ft. to 19 1/2 ft., From 6 ft. to 19 1/2 ft.

6 GROUT MATERIAL:  1 Neat cement  2 Cement grout  3 Bentonite  4 Other  
 Grout Intervals: From 0 ft. to 6 ft., From 6 ft. to 6 ft., From 6 ft. to 6 ft., From 6 ft. to 6 ft.  
 What is the nearest source of possible contamination:  
 1 Septic tank  4 Lateral lines  7 Pit privy  10 Livestock pens  14 Abandoned water well  
 2 Sewer lines  5 Cess pool  8 Sewage lagoon  11 Fuel storage  15 Oil well/Gas well  
 3 Watertight sewer lines  6 Seepage pit  9 Feedyard  12 Fertilizer storage  16 Other (specify below)  
 13 Insecticide storage  
 Direction from well? North How many feet? 65' Home

FROM	TO	LITHOLOGIC LOG	FROM	TO	PLUGGING INTERVALS
		<u>Well #2</u>			
<u>0</u>	<u>3</u>	<u>Dark brown soil</u>			
<u>3</u>	<u>6</u>	<u>red-brown silty and sandy soil</u>			
<u>6</u>	<u>16</u>	<u>Fine granite sand primarily, some coarse sand and gravel.</u>			
<u>16</u>	<u>19 1/2</u>	<u>Gray, green-gray and gray-black clay.</u>			

7 CONTRACTOR'S OR LANDOWNER'S CERTIFICATION: This water well was  (1) constructed, (2) reconstructed, or (3) plugged under my jurisdiction and was completed on (mo/day/year) 01-15-96 and this record is true to the best of my knowledge and belief. Kansas Water Well Contractor's License No. 579 This Water Well Record was completed on (mo/day/yr) Jan 29, 1996 under the business name of Stobbe Well Drilling & Service by (signature) William J. Stobbe