


1 LOCATION OF WATER WELL: **Sumner** FRACTION: **SW 1/4 SE 1/4 NE 1/4** Section Number: **4** Township Number: **T 30 S** Range Number: **R 1E E/W**

Distance and direction from nearest town or city street address of well if located within city?  
**Hydraulic & 119th S., 1/2 m. S., West 1/4 m., 1 block N. Peck, KS.**

WATER WELL OWNER: **BERG, Steve**  
 RR#, ST. ADDRESS, BOX #: **1442 Tomahawk**  
 CITY, STATE, ZIP CODE: **Peck, Kansas**  
 Board of Agriculture, Division of Water Resource  
 Application Number:

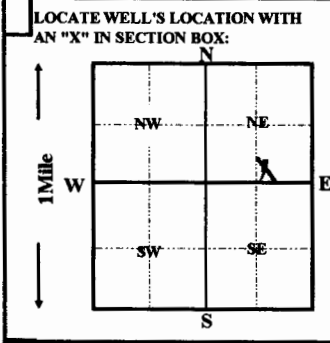

4 DEPTH OF COMPLETED WELL **35** ft. ELEVATION:  
 Depth(s) groundwater Encountered 1 ft. 2 ft. 3 ft.  
 WELL'S STATIC WATER LEVEL **15** FT. BELOW LAND SURFACE MEASURED ON **06/20/1996**  
 Pump test data: Well water was \_\_\_\_\_ ft. after \_\_\_\_\_ hours pumping \_\_\_\_\_ gpm  
 Est. Yield \_\_\_\_\_ gpm: Well water was \_\_\_\_\_ ft. after \_\_\_\_\_ hours pumping \_\_\_\_\_ gpm  
 Bore Hole Diameter **12** in. to **35** ft. and \_\_\_\_\_ in. to \_\_\_\_\_ ft.  
 WELL WATER TO BE USED AS: 5 Public water supply 8 Air conditioning 11 Injection well  
 1 Domestic 3 Feedlot 6 Oil field water supply 9 Dewatering 12 Other (Specify below)  
 2 Irrigation 4 Industrial 7 Lawn and garden only 10 Monitoring well  
 Was a chemical/bacteriological sample submitted to Department? Yes \_\_\_\_\_ No  ; If yes, mo/day/yr sample was submitted  
 Water Well Disinfected? Yes  No

5 TYPE OF CASING USED:  
 1 Steel 3 RMP (SR) 5 Wrought iron 8 Concrete tile CASING JOINTS: Glued  Clamped  
 2 PVC 4 ABS 6 Asbestos-Cement 9 Other (Specify below) Welded  
 7 Fiberglass **SDR-26** Threaded  
 Blank casing Diameter **5** in. to **25** ft., Dia \_\_\_\_\_ in. to \_\_\_\_\_ ft.  
 Casing height above land surface **12** in., weight **2.35** lbs. / ft. Wall thickness or gauge No. **.214**  
 TYPE OF SCREEN OR PERFORATION MATERIAL:  
 1 Steel 3 Stainless Steel 5 Fiberglass 8 RMP (SR) 10 Asbestos-cement  
 2 Brass 4 Galvanized steel 6 Concrete tile 9 ABS 11 other (specify)  
 12 None used (open hole)  
 SCREEN OR PERFORATION OPENING ARE:  
 1 Continuous slot 3 Mill slot 5 Gauzed wrapped 8 Saw cut 11 None (open hole)  
 2 Louvered shutter 4 Key punched 6 Wire wrapped 9 Drilled holes  
 7 Torch cut 10 Other (specify)  
 SCREEN-PERFORATION INTERVALS: from **25** ft. to **35** ft., From \_\_\_\_\_ ft. to \_\_\_\_\_ ft.  
 GRAVEL PACK INTERVALS: from **24** ft. to **35** ft., From \_\_\_\_\_ ft. to \_\_\_\_\_ ft.

6 GROUT MATERIAL: 1 Neat cement 2 Cement grout 3 Bentonite 4 Other  
 Grout Intervals: From **4** ft. to **24** ft. From \_\_\_\_\_ ft. to \_\_\_\_\_ ft.  
 What is the nearest source of possible contamination:  
 1 Septic tank 4 Lateral lines 7 Pit privy 10 Livestock pens 14 Abandon water well  
 2 Sewer lines 5 Cess pool 8 Sewage lagoon 11 Fuel storage 15 Oil well/Gas well  
 3 Watertight sewer lines 6 Seepage pit 9 Feedyard 12 Fertilizer storage 16 Other (specify below)  
 13 Insecticide storage **None Apparent**  
 Direction from well? \_\_\_\_\_ How many feet? \_\_\_\_\_

FROM	TO	LITHOLOGIC LOG	FROM	TO	PLUGGING INTERVALS
0	2	topsoil			
2	15	clay			
15	30	medium sand			
30	35	shale			

7 CONTRACTOR'S OR LANDOWNER'S CERTIFICATION: This water well was (1) constructed, (2) reconstructed, or (3) plugged under my jurisdiction and was completed on (mo/day/year) **06/20/1996** and this record is true to the best of my knowledge and belief. Kansas Water Well Contractor's License No. **236** This Water Well Record was completed on (mo/day/yr) **06/21/96**  
 Under the business name of **Harp Well & Pump Service, Inc.** by (signature) **Todd S. Harp**