


1 LOCATION OF WATER WELL: Fraction SW 1/4 NW 1/4 SW 1/4 Section Number 23 Township Number T 30 S Range Number R 10 W
 County: Sumner
 Distance and direction from nearest town or city street address of well if located within city?
1154 N. Hillside

2 WATER WELL OWNER: Weber Homes
 RR#, St. Address, Box #: 1590 E. Deer Trail Drive Board of Agriculture, Division of Water Resources
 City, State, ZIP Code: Mulvane, KS 67110 Application Number:

3 LOCATE WELL'S LOCATION WITH AN "X" IN SECTION BOX:

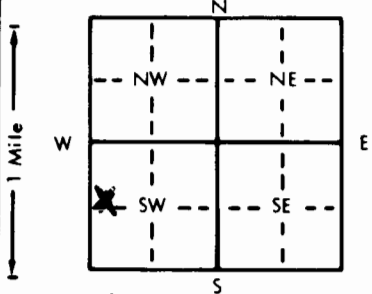

4 DEPTH OF COMPLETED WELL: 34 ft. ELEVATION:

Depth(s) Groundwater Encountered 1. 14 ft. 2. 14 ft. 3. 14 ft.
 WELL'S STATIC WATER LEVEL 14 ft. below land surface measured on mo/day/yr 1-20-97
 Pump test data: Well water was 20 gpm ft. after 34 hours pumping 1-20-97 gpm
 Est. Yield 20 gpm: Well water was 34 ft. after 34 hours pumping 1-20-97 gpm
 Bore Hole Diameter 11 in. to 34 ft. and 34 in. to 34 ft.
 WELL WATER TO BE USED AS: 5 Public water supply 8 Air conditioning 11 Injection well
 Domestic 3 Feedlot 6 Oil field water supply 9 Dewatering 12 Other (Specify below)
 2 Irrigation 4 Industrial 7 Lawn and garden only 10 Monitoring well
 Was a chemical/bacteriological sample submitted to Department? Yes X No X If yes, mo/day/yr sample was submitted
 Water Well Disinfected? Yes X No X

5 TYPE OF BLANK CASING USED: 5 Wrought iron 8 Concrete tile CASING JOINTS: Glued X Clamped
 1 Steel 3 RMP (SR) 6 Asbestos-Cement 9 Other (specify below) Welded
 2 PVC 5 4 ABS 7 Fiberglass Threaded
 Blank casing diameter 5 in. to 22 ft., Dia. 2.40 in. to 100 PSI ft.
 Casing height above land surface 12 in., weight 2.40 lbs./ft. Wall thickness or gauge No. 100 PSI

TYPE OF SCREEN OR PERFORATION MATERIAL: 7 PVC 10 Asbestos-cement
 1 Steel 3 Stainless steel 5 Fiberglass 8 RMP (SR) 11 Other (specify)
 2 Brass 4 Galvanized steel 6 Concrete tile 9 ABS 12 None used (open hole)

SCREEN OR PERFORATION OPENINGS ARE: 5 Gauzed wrapped 8 Saw cut 11 None (open hole)
 1 Continuous slot 3 Mill slot 6 Wire wrapped 9 Drilled holes
 2 Louvered shutter 4 Key punched 7 Torch cut 10 Other (specify)


6 GROUT MATERIAL: 3 1 Neat cement 14 2 Cement grout 3 Bentonite 4 Other
 What is the nearest source of possible contamination:
 1 Septic tank 4 Lateral lines 7 Pit privy 10 Livestock pens 14 Abandoned water well
 2 Sewer lines 5 Cess pool 8 Sewage lagoon 11 Fuel storage 15 Oil well/Gas well
 3 Watertight sewer lines 6 Seepage pit 9 Feedyard 12 Fertilizer storage 16 Other (specify below)
 13 Insecticide storage
 Direction from well? Southeast How many feet? 180

FROM	TO	LITHOLOGIC LOG	FROM	TO	PLUGGING INTERVALS
0	6	Clay fine sand sand shale			
6	18				
18	34				
34					

7 CONTRACTOR'S OR LANDOWNER'S CERTIFICATION: This water well was (1) constructed, (2) reconstructed, or (3) plugged under my jurisdiction and was completed on (mo/day/year) 1-20-97 and this record is true to the best of my knowledge and belief. Kansas Water Well Contractor's License No. 318 This Water Well Record was completed on (mo/day/yr) 1-21-97 under the business name of Weninger Drilling Inc. by (signature) Michelle Becker

OFFICE USE ONLY
T
R
EW
SEC
1/4
1/4
1/4