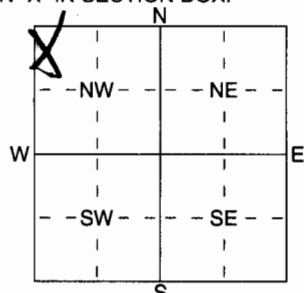


1 LOCATION OF WATER WELL: Fraction NW 1/4 NW 1/4 NW 1/4 Section Number 6 Township Number T 300 S Range Number R 10 E/V
 County: Sumner

Distance and direction from nearest town or city street address of well if located within city?
1374 N. Ridge rd. Peck, KS

2 WATER WELL OWNER: Scott Nienke
 RR#, St. Address, Box # : 1374 N. Ridge rd. Peck, KS 67120 Board of Agriculture, Division of Water Resources
 City, State, ZIP Code : 1374 N. Ridge rd. Peck, KS 67120 Application Number:

3 LOCATE WELL'S LOCATION WITH AN "X" IN SECTION BOX:

 4 DEPTH OF COMPLETED WELL 35 ft. ELEVATION:
 Depth(s) Groundwater Encountered ft. 2 ft. 3 ft.
 WELL'S STATIC WATER LEVEL 20 ft. below land surface measured on mo/day/yr
 Pump test data: Well water was ft. after hours pumping gpm
 Est. Yield 10 gpm: Well water was ft. after hours pumping gpm
 WELL WATER TO BE USED AS: 5 Public water supply 8 Air conditioning 11 Injection well
 1 Domestic 3 Feedlot 6 Oil field water supply 9 Dewatering 12 Other (Specify below)
 2 Irrigation 4 Industrial 7 Domestic (lawn & garden) 10 Monitoring well
 Was a chemical/bacteriological sample submitted to Department? Yes No X; If yes, mo/day/yr sample was submitted
 Water Well Disinfected? Yes No

5 TYPE OF BLANK CASING USED:
 1 Steel 3 RMP (SR) 5 Wrought iron 8 Concrete tile CASING JOINTS: Glued X Clamped
2 PVC 4 ABS 6 Asbestos-Cement 9 Other (specify below) Welded
 7 Fiberglass Threaded
 Blank casing diameter 5" in. to 35 ft. Dia in. to ft. Dia in. to ft.
 Casing height above land surface 12" in., weight 2.4 lbs./ft. Wall thickness or gauge No. 16.0 PSI
 TYPE OF SCREEN OR PERFORATION MATERIAL:
 1 Steel 3 Stainless Steel 5 Fiberglass 7 PVC 10 Asbestos-Cement
 2 Brass 4 Galvanized Steel 6 Concrete tile 8 RMP (SR) 11 Other (Specify)
 9 ABS 12 None used (open hole)
 SCREEN OR PERFORATION OPENINGS ARE:
 1 Continuous slot 3 Mill slot 35 5 Gauzed wrapped 8 Saw cut 11 None (open hole)
 2 Louvered shutter 4 Key punched 6 Wire wrapped 9 Drilled holes 7 Torch cut 10 Other (specify) ft.
 SCREEN-PERFORATED INTERVALS: From 35 ft. to ft. From 95 ft. to ft.
 GRAVEL PACK INTERVALS: From 20 ft. to ft. From 95 ft. to ft.

6 GROUT MATERIAL: 3 Neat cement 20 Cement grout 3 Bentonite 4 Other
 Grout Intervals: From 3 ft. to 20 ft., From ft. to ft., From ft. to ft.
 What is the nearest source of possible contamination:
 1 Septic tank 4 Lateral lines 7 Pit privy 10 Livestock pens 14 Abandoned water well
 2 Sewer lines 5 Cess pool 8 Sewage lagoon 11 Fuel storage 15 Oil well/Gas well
3 Watertight sewer lines 6 Seepage pit 9 Feedyard 12 Fertilizer storage 16 Other (specify below)
 13 Insecticide storage
 Direction from well? east How many feet? 15

FROM	TO	LITHOLOGIC LOG	FROM	TO	PLUGGING INTERVALS
0	1	topsoil			
1	5	clay			
5	25	fine sand			
25	30	med sand			
30	35	gravel			
35	95	shale			

7 CONTRACTOR'S OR LANDOWNER'S CERTIFICATION: This water well was (1) constructed, (2) reconstructed, or (3) plugged under my jurisdiction and was completed on (mo/day/year) #1740 1/15/05 and this record is true to the best of my knowledge and belief. Kansas Water Well Contractor's Licence No This Water Well Record was completed on (mo/day/yr) 1/15/05 under the business name of Weninger Drilling Inc by signature aweninger