


1 LOCATION OF WATER WELL: County: SUMNER Fraction SW 1/4 NW 1/4 Section Number 4 Township Number T 30 S Range Number R 1 E EW

Distance and direction from nearest town or city street address of well if located within city? Lot 42 Country Estates 1/2 So. of County line on 81 Peck, Ks.

2 WATER WELL OWNER: Gasaway Construction RR#, St. Address, Box # : 200 So. Brookwood Board of Agriculture, Division of Water Resources City, State, ZIP Code : Wichita, Kansas Application Number:

3 LOCATE WELL'S LOCATION WITH AN 'X' IN SECTION BOX: 4 DEPTH OF COMPLETED WELL 45 ft. ELEVATION: 15 ft. below land surface measured on mo/day/yr 8-30-83

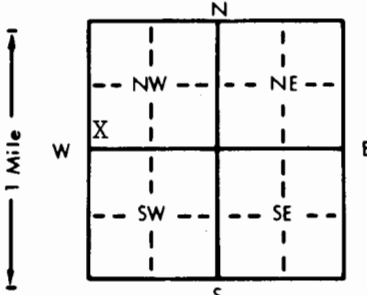

WELL'S STATIC WATER LEVEL 15 ft. below land surface measured on mo/day/yr 8-30-83. Pump test data: Well water was ... ft. after ... hours pumping ... gpm. Est. Yield ... gpm. Bore Hole Diameter 11 in. to ... ft., and ... in. to ... ft. WELL WATER TO BE USED AS: 5 Public water supply, 8 Air conditioning, 11 Injection well, 1 Domestic, 3 Feedlot, 6 Oil field water supply, 9 Dewatering, 12 Other (Specify below), 2 Irrigation, 4 Industrial, 7 Lawn and garden only, 10 Observation well. Was a chemical/bacteriological sample submitted to Department? Yes ... No X. If yes, mo/day/yr sample was submitted ... Water Well Disinfected? Yes X No

5 TYPE OF BLANK CASING USED: 1 Steel, 3 RMP (SR), 2 PVC, 4 ABS, 5 Wrought iron, 6 Asbestos-Cement, 7 Fiberglass, Cer-Mac styrene SDR-26, 8 Concrete tile, 9 Other (specify below), 10 Asbestos-cement, 11 Other (specify), 12 None used (open hole). CASING JOINTS: Glued X Clamped, Welded, Threaded.

Blank casing diameter 5 in. to 30 ft., Dia in. to ... ft., Dia in. to ... in. to ... ft. Casing height above land surface 12 in., weight 1.59 lbs./ft. Wall thickness or gauge No. 203

TYPE OF SCREEN OR PERFORATION MATERIAL: 1 Steel, 3 Stainless steel, 5 Fiberglass, 8 RMP (SR), 2 Brass, 4 Galvanized steel, 6 Concrete tile, 9 ABS, 7 PVC, 10 Asbestos-cement, 11 Other (specify), 12 None used (open hole)

SCREEN OR PERFORATION OPENINGS ARE: 1 Continuous slot, 3 Mill slot, 5 Gauzed wrapped, 8 Saw cut, 11 None (open hole), 2 Louvered shutter, 4 Key punched, 6 Wire wrapped, 9 Drilled holes, 7 Torch cut, 10 Other (specify)

SCREEN-PERFORATED INTERVALS: From 30 ft. to 45 ft., From ... ft. to ... ft., From ... ft. to ... ft.

GRAVEL PACK INTERVALS: From 14 ft. to 45 ft., From ... ft. to ... ft., From ... ft. to ... ft.

6 GROUT MATERIAL: 1 Neat cement, 2 Cement grout, 3 Bentonite, 4 Other. Grout Intervals: From 4 ft. to 14 ft., From ... ft. to ... ft., From ... ft. to ... ft.

What is the nearest source of possible contamination: 1 Septic tank, 4 Lateral lines, 7 Pit privy, 10 Livestock pens, 14 Abandoned water well, 2 Sewer lines, 5 Cess pool, 8 Sewage lagoon, 11 Fuel storage, 15 Oil well/Gas well, 3 Watertight sewer lines, 6 Seepage pit, 9 Feedyard, 12 Fertilizer storage, 16 Other (specify below), 13 Insecticide storage

Direction from well? South How many feet? 50

LITHOLOGIC LOG table with columns FROM, TO, and LITHOLOGIC LOG. Entries include Topsoil (0-3), Clay (3-13), Fine Sand (13-23), and Medium Sand (23-45).

7 CONTRACTOR'S OR LANDOWNER'S CERTIFICATION: This water well was (1) constructed (2) reconstructed, or (3) plugged under my jurisdiction and was completed on (mo/day/year) 8-30-83 and this record is true to the best of my knowledge and belief. Kansas Water Well Contractor's License No. 236 This Water Well Record was completed on (mo/day/yr) 12-30-83

under the business name of Harp Well & Pump Service, Inc. by (signature) Mary Arnold

INSTRUCTIONS: Use typewriter or ball point pen, PLEASE PRESS FIRMLY and PRINT clearly. Please fill in blanks, underline or circle the correct answers. Send top three copies to Kansas Department of Health and Environment, Division of Environment, Environmental Geology Section, Topeka, KS 66620. Send one to WATER WELL OWNER and retain one for your records.

OFFICE USE ONLY

T

30 R

EW

SEC:

4

SW 1/4 SW 1/4 NW 1/4

SEC:

4

SW 1/4 SW 1/4 NW 1/4