


1 LOCATION OF WATER WELL: Sumner	FRACTION SE 1/4 SW 1/4 SE 1/4	Section Number 4	Township Number T 30 S	Range Number R 1E E/W
--	---	----------------------------	----------------------------------	---------------------------------

Distance and direction from nearest town or city street address of well if located within city?

11929 S. Washington Peck, Kansas

WATER WELL OWNER: PARKER, Bob	Board of Agriculture, Division of Water Resource
RR#, ST. ADDRESS, BOX #: 11929 S. Washington	Application Number:
CITY, STATE, ZIP CODE: Peck, Kansas	

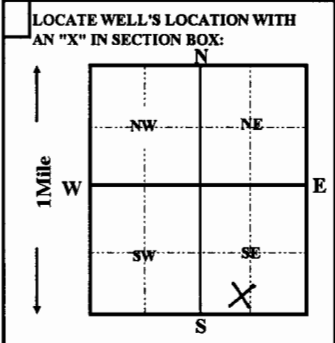

4 DEPTH OF COMPLETED WELL 40 ft.	ELEVATION:
Depth(s) groundwater Encountered 1 ft.	2 ft.
WELL'S STATIC WATER LEVEL 15	FT. BELOW LAND SURFACE MEASURED ON 08/05/1998
Pump test data: Well water was _____ ft. after _____ hours pumping _____ gpm	
Est. Yield _____ gpm:	Well water was _____ ft. after _____ hours pumping _____ gpm
Bore Hole Diameter 12 in. to 40 ft.	and _____ in. to _____ ft.
WELL WATER TO BE USED AS: 5 Public water supply	8 Air conditioning
1 Domestic	11 Injection well
3 Feedlot	9 Dewatering
6 Oil field water supply	12 Other (Specify below)
2 Irrigation	4 Industrial
7 Lawn and garden only	10 Monitoring well
Was a chemical/bacteriological sample submitted to Department? Yes _____ No X ; If yes, mo/day/yr sample was submitted	Water Well Disinfected? Yes X No _____

5 TYPE OF CASING USED: 1 Steel 3 RMP (SR) 2 PVC 4 ABS	5 Wrought iron 6 Asbestos-Cement 7 Fiberglass	8 Concrete tile 9 Other (Specify below) SDR-26	CASING JOINTS: Glued X Clamped Welded Threaded
Blank casing Diameter 5 in. to 20 ft., Dia	Weight 2.35 lbs. / ft.	Wall thickness or gauge No. .214	
Casing height above land surface 12 in.,			
TYPE OF SCREEN OR PERFORATION MATERIAL: 1 Steel 3 Stainless Steel 2 Brass 4 Galvanized steel	5 Fiberglass 6 Concrete tile	7 PVC 8 RMP (SR) 9 ABS	10 Asbestos-cement 11 other (specify) 12 None used (open hole)
SCREEN OR PERFORATION OPENING ARE: 1 Continous slot 3 Mill slot 2 Louvered shutter 4 Key punched	5 Gauzed wrapped 6 Wire wrapped 7 Torch cut	8 Saw cut 9 Drilled holes 10 Other (specify)	11 None (open hole)
SCREEN-PERFORATION INTERVALS: from 20 ft. to 30 ft., From			
GRAVEL PACK INTERVALS: from 20 ft. to 40 ft., From			

6 GROUT MATERIAL: 1 Neat cement 2 Cement grout 3 Bentonite 4 Other bentonite hole plug
Grout Intervals: From 0 ft. to 20 ft. From _____ ft. to _____ ft.
What is the nearest source of possible contamination: 1 Septic tank 4 Lateral lines 7 Pit privy 10 Livestock pens 14 Abandon water well 2 Sewer lines 5 Cess pool 8 Sewage lagoon 11 Fuel storage 15 Oil well/Gas well 3 Watertight sewer lines 6 Seepage pit 9 Feedyard 12 Fertilizer storage 16 Other (specify below)
None Apparent

Direction from well?		How many feet?					
FROM	TO	LITHOLOGIC LOG		FROM	TO	PLUGGING INTERVALS	
0	2	topsoil					
2	15	clay					
15	30	medium coarse sand					
30	40	shale					

7 CONTRACTOR'S OR LANDOWNER'S CERTIFICATION: This water well was (1) constructed, (2) reconstructed, or (3) plugged under my jurisdiction and was completed on (mo/day/year) **08/05/1998** and this record is true to the best of my knowledge and belief. Kansas Water Well Contractor's License No. **236** This Water Well Record was completed on (mo/day/yr) **08/07/98** Under the business name of **Harp Well & Pump Service, Inc.** by (signature) *Todd S. Harp*