

WATER WELL PLUGGING RECORD Form WWC-5P KSA 82a-1212 ID NO.


MW7

1 LOCATION OF WATER WELL: County: Sumner Fraction SW 1/4 SW 1/4 SW 1/4 SW 1/4 Section Number 36 Township Number T 30 S Range Number 1 [X] E [ ] W

Street/Rural Address of Well Location: if unknown, distance & direction from nearest town or intersection: If at owner's address, check here [ ] 400 E 4th, Belle Plaine, KS

Global Positioning Systems (GPS) information: Latitude: NA (in decimal degrees) Longitude: NA (in decimal degrees) Elevation: NA Horizontal Datum [ ] WGS84, [ ] NAD83, [ ] NAD27 Collection Method: [ ] GPS unit (Make/model): [ ] Digital Map/Photo, [ ] Topographic Map, [ ] Land Survey Est. Accuracy: [ ] <3 m, [ ] 3-5 m, [ ] 5-15 m, [ ] >15 m

2 WATER WELL OWNER: Flaming Investments RR#, St. Address, Box #: PO Box 580 City, State ZIP Code: Belle Plaine, KS

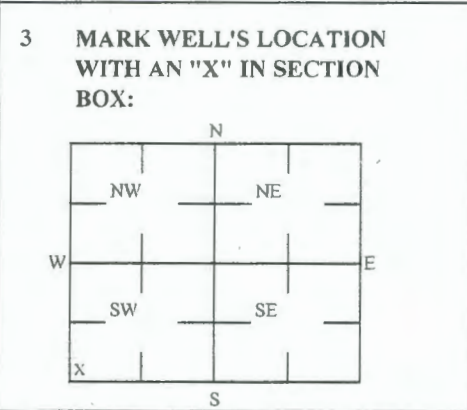

4 DEPTH OF WELL 22 ft. WELL'S STATIC WATER LEVEL \_\_\_\_\_ ft. WELL WAS USED AS: [ ] Domestic, [ ] Irrigation, [ ] Feedlot, [ ] Industrial, [ ] Public Water Supply, [ ] Oil Field Water Supply, [ ] Domestic (Lawn & Garden), [ ] Air Conditioning, [ ] Dewatering, [X] Monitoring, [ ] Injection Well, [ ] Other. Was a chemical/bacteriological sample submitted to Department? Yes [ ] No [X]

5 TYPE OF BLANK CASING USED: [ ] Steel, [X] PVC, [ ] RMP (SR), [ ] ABS, [ ] Wrought, [ ] Asbestos-Cement, [ ] Fiberglass, [ ] Concrete Tile, [ ] Other (Specific below) Blank casing diameter 2 in. Was casing pulled? Yes [X] No [ ] If yes, how much 3' Casing height above or below land surface NA in.

6 GROUT PLUG MATERIAL: [ ] Neat cement, [ ] Cement grout, [X] Bentonite, [X] Other Soil: 0-0.5' Grout Plug Intervals: From 0.5 ft to 22 ft, From \_\_\_\_\_ ft to \_\_\_\_\_ ft, From \_\_\_\_\_ ft to \_\_\_\_\_ ft. What is the nearest source of possible contamination: [ ] Septic tank, [ ] Sewer lines, [ ] Watertight sewer lines, [ ] Lateral lines, [ ] Cess pool, [ ] Seepage pit, [ ] Pit privy, [ ] Sewage lagoon, [ ] Feed yard, [ ] Livestock pens, [ ] Fuel storage, [ ] Fertilizer storage, [ ] Insecticide storage, [ ] Abandoned water well, [ ] Oil well/Gas well, [ ] Other (specify below) Direction from well? \_\_\_\_\_ How many feet? \_\_\_\_\_

Table with columns: FROM, TO, PLUGGING MATERIALS. Row 1: 0, 0.5, Soil. Row 2: 0.5, 22, Bentonite. KDHE ID: SAV-A-TRIP #6; U2-096-11160

7 CONTRACTOR'S OR LANDOWNER'S CERTIFICATION: This water well was plugged under my jurisdiction and was completed on (mo/day/year) 9/18/2018 and this record is true to the best of my knowledge and belief. Kansas Water Contractor's License No. 757. This Water Well Record was completed on (mo/day/year) 10/3/2018 under the business name of Larsen & Associates, Inc. By (signature) [Signature]

Send one white copy to Kansas Department of Health & Environment, Geology Section, 1000 SW Jackson Street, Ste. 420, Topeka, KS 66612-1367. Send one copy to WATER WELL OWNER and retain one for your records. Visit us at http://www.kdheks.gov/waterwell/index.html Telephone 785-296-5524.