

CORRECTION(S) TO WATER WELL RECORD (WWC-5)

(to rectify lacking or incorrect information)

County: Sumner

Location listed as:

Section-Township-Range: 2-30S-1E

Fraction ($\frac{1}{4}$ $\frac{1}{4}$ $\frac{1}{4}$): SW SW NW

Location changed to:

13-30S-1E

SW NW SW

Other changes: Initial statements: _____

Changed to: _____

Comments: _____

verification method: Well address, area map on internet, and
KGIS WWC5 mapping application & aerial photos online.

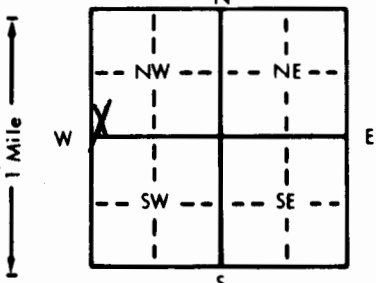
initials: DRJ date: 9/7/2005

1 LOCATION OF WATER WELL: County: <u>Sumner</u>	Fraction <u>SW 1/4 SW 1/4 NW 1/4</u>	Section Number <u>2</u>	Township Number <u>T 30 S</u>	Range Number <u>R 1 E</u> (EW)
--	---	----------------------------	----------------------------------	--

Distance and direction from nearest town or city street address of well if located within city?

12346 South Oliver Wichita, Kansas

2 WATER WELL OWNER: RR#, St. Address, Box # : City, State, ZIP Code	<u>Thomas Lamar</u> <u>12346 South Oliver</u> <u>Wichita, Belle Plaine KS.</u>	Board of Agriculture, Division of Water Resources Application Number:
---	---	--

3 LOCATE WELL'S LOCATION WITH AN "X" IN SECTION BOX: 	4 DEPTH OF COMPLETED WELL: <u>35</u> ft. ELEVATION:
	Depth(s) Groundwater Encountered 1. <u>12</u> ft. 2. ft. 3. ft. WELL'S STATIC WATER LEVEL ... <u>12</u> ft. below land surface measured on mo/day/yr ... <u>12-1-87</u> Pump test data: Well water was ft. after hours pumping gpm Est. Yield gpm: Well water was ft. after hours pumping gpm Bore Hole Diameter: in. to ft., and in. to ft. WELL WATER TO BE USED AS: 5 Public water supply 8 Air conditioning 11 Injection well 1 Domestic 3 Feedlot 6 Oil field water supply 9 Dewatering 12 Other (Specify below) 2 Irrigation 4 Industrial 7 Lawn and garden only 10 Monitoring well Was a chemical/bacteriological sample submitted to Department? Yes.....No.....; If yes, mo/day/yr sample was submitted Water Well Disinfected? Yes No

5 TYPE OF BLANK CASING USED: 1 Steel 3 RMP (SR) 2 PVC 4 ABS	5 Wrought iron 8 Concrete tile 6 Asbestos-Cement 9 Other (specify below) 7 Fiberglass	CASING JOINTS: Glued Clamped Welded Threaded
Blank casing diameter 5 in. to ft., Dia in. to ft., Dia in. to ft. Casing height above land surface... <u>SEE BELOW</u> in., weight lbs./ft. Wall thickness or gauge No.	TYPE OF SCREEN OR PERFORATION MATERIAL: 1 Steel 3 Stainless steel 5 Fiberglass 8 RMP (SR) 10 Asbestos-cement 2 Brass 4 Galvanized steel 6 Concrete tile 9 ABS 11 Other (specify) 12 None used (open hole)	
SCREEN OR PERFORATION OPENINGS ARE: 1 Continuous slot 3 Mill slot 2 Louvered shutter 4 Key punched	5 Gauzed wrapped 8 Saw cut 11 None (open hole) 6 Wire wrapped 9 Drilled holes 7 Torch cut 10 Other (specify)	
SCREEN-PERFORATED INTERVALS: From ft. to ft., From ft. to ft. GRAVEL PACK INTERVALS: From ft. to ft., From ft. to ft.		

6 GROUT MATERIAL: 1 Neat cement 2 Cement grout 3 Bentonite 4 Other	Grout Intervals: From ft. to ft., From <u>4</u> ft. to <u>24</u> ft., From ft. to ft.
What is the nearest source of possible contamination: 1 Septic tank 4 Lateral lines 7 Pit privy 10 Livestock pens 14 Abandoned water well 2 Sewer lines 5 Cess pool 8 Sewage lagoon 11 Fuel storage 15 Oil well/Gas well 3 Watertight sewer lines 6 Seepage pit 9 Feedyard 12 Fertilizer storage 16 Other (specify below) 13 Insecticide storage ... <u>None apparent</u>	Direction from well? How many feet?

FROM	TO	LITHOLOGIC LOG	FROM	TO	PLUGGING INTERVALS
			35	24	Chlorinated Sand
			24	4	Bentonite
					4' Below Ground Level

7 CONTRACTOR'S OR LANDOWNER'S CERTIFICATION: This water well was (1) constructed, (2) reconstructed, or (3) plugged under my jurisdiction and was completed on (mo/day/year) <u>12-1-87</u> and this record is true to the best of my knowledge and belief. Kansas Water Well Contractor's License No. <u>236</u> This Water Well Record was completed on (mo/day/yr) <u>5-11-88</u> under the business name of <u>Harp Well & Pump Service, Inc.</u> by (signature) <u>Mary Arnold</u>
