

CORRECTION(S) TO WATER WELL RECORD (WWC-5)

(to rectify lacking or incorrect information)

County: Sumner

Location listed as:

Section-Township-Range: 2-30S-1E

Fraction ($\frac{1}{4}$ $\frac{1}{4}$ $\frac{1}{4}$): SW SW NW

Location changed to:

13-30S-1E

SW NW SW

Other changes: Initial statements: _____

Changed to: _____

Comments: _____

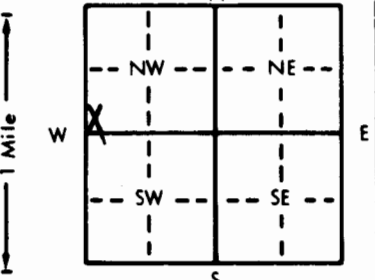
verification method: well address, area map on internet, and
KGS WWC5 mapping application & aerial photos online.

initials: DRJ date: 9/7/2005

1 LOCATION OF WATER WELL: SUMNER
 County: SUMNER Fraction SW 1/4 SW 1/4 NW 1/4 Section Number 2 Township Number T 30 S Range Number R 1 E E/W

Distance and direction from nearest town or city street address of well if located within city?
 12346 South Oliver Wichita, Kansas

2 WATER WELL OWNER: Thomas Lamar
 RR#, St. Address, Box #: 12346 South Oliver Board of Agriculture, Division of Water Resources
 City, State, ZIP Code: Wichita, Kansas Application Number:

3 LOCATE WELL'S LOCATION WITH AN "X" IN SECTION BOX:

 4 DEPTH OF COMPLETED WELL: 27 ft. ELEVATION:
 Depth(s) Groundwater Encountered 1. ft. 2. ft. 3. ft.
 WELL'S STATIC WATER LEVEL . . . 12 . . . ft. below land surface measured on mo/day/yr . . . 12-1-87 . . .
 Pump test data: Well water was ft. after hours pumping gpm
 Est. Yield gpm: Well water was ft. after hours pumping gpm
 Bore Hole Diameter . . . 1 1/4 . . . in. to ft., and in. to ft.
 WELL WATER TO BE USED AS:
 1 Domestic 2 Irrigation 3 Feedlot 4 Industrial 5 Public water supply 6 Oil field water supply 7 Lawn and garden only 8 Air conditioning 9 Dewatering 10 Monitoring well 11 Injection well 12 Other (Specify below)
 Was a chemical/bacteriological sample submitted to Department? Yes No X; If yes, mo/day/yr sample was submitted
 Water Well Disinfected? Yes X No

5 TYPE OF BLANK CASING USED:
 1 Steel 2 PVC 3 RMP (SR) 4 ABS 5 Wrought iron 6 Asbestos-Cement 7 Fiberglass 8 Concrete tile 9 Other (specify below)
 Blank casing diameter . . . 1 1/4 . . . in. to ft., Dia in. to ft., Dia in. to ft.
 Casing height above land surface. See Below in., weight lbs./ft. Wall thickness or gauge No.
 TYPE OF SCREEN OR PERFORATION MATERIAL:
 1 Steel 2 Brass 3 Stainless steel 4 Galvanized steel 5 Fiberglass 6 Concrete tile 7 PVC 8 RMP (SR) 9 ABS 10 Asbestos-cement 11 Other (specify) 12 None used (open hole)
 SCREEN OR PERFORATION OPENINGS ARE:
 1 Continuous slot 2 Louvered shutter 3 Mill slot 4 Key punched 5 Gauzed wrapped 6 Wire wrapped 7 Torch cut 8 Saw cut 9 Drilled holes 11 None (open hole)
 SCREEN-PERFORATED INTERVALS: From ft. to ft., From ft. to ft., From ft. to ft.
 GRAVEL PACK INTERVALS: From ft. to ft., From ft. to ft., From ft. to ft.

6 GROUT MATERIAL: 1 Neat cement 2 Cement grout 3 Bentonite 4 Other
 Grout Intervals: From ft. to ft., From 4 . . . ft. to 20 . . . ft., From ft. to ft.
 What is the nearest source of possible contamination:
 1 Septic tank 2 Sewer lines 3 Watertight sewer lines 4 Lateral lines 5 Cess pool 6 Seepage pit 7 Pit privy 8 Sewage lagoon 9 Feedyard 10 Livestock pens 11 Fuel storage 12 Fertilizer storage 13 Insecticide storage 14 Abandoned water well 15 Oil well/Gas well 16 Other (specify below) None apparent
 Direction from well? How many feet?

FROM	TO	LITHOLOGIC LOG	FROM	TO	PLUGGING INTERVALS
			27	20	Chlorinated Sand
			20	4	Bentonite

7 CONTRACTOR'S OR LANDOWNER'S CERTIFICATION: This water well was (1) constructed, (2) reconstructed, or (3) plugged under my jurisdiction and was completed on (mo/day/year) 12-1-87 and this record is true to the best of my knowledge and belief. Kansas Water Well Contractor's License No. 236 This Water Well Record was completed on (mo/day/yr) 5-11-88 under the business name of Harp Well & Pump Service, Inc. by (signature) *Mary Arnold*