


1	LOCATION OF WATER WELL: Sumner	FRACTION SE 1/4 SE 1/4 NE 1/4	Section Number 4	Township Number T 30 S	Range Number R 1E E/W
---	--	---	----------------------------	----------------------------------	---------------------------------

Distance and direction from nearest town or city street address of well if located within city?

1/2 S. of 119th S., 100 yds. W. of Hydraulic Peck, Kansas

2	WATER WELL OWNER: LINDER, Leo RR#, ST. ADDRESS, BOX #: R#1 Box 328A CITY, STATE, ZIP CODE: Peck, Kansas 67120	Board of Agriculture, Division of Water Resource Application Number:
---	---	---

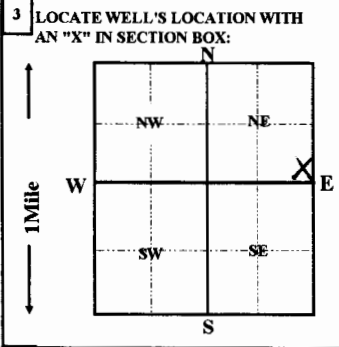

4	DEPTH OF COMPLETED WELL 35 ft. ELEVATION:	
	Depth(s) groundwater Encountered 1 ft. 2 ft. 3 ft.	
	WELL'S STATIC WATER LEVEL 18 FT. BELOW LAND SURFACE MEASURED ON 11/09/1992	
	Pump test data: Well water was ft. after hours pumping gpm	
	Est. Yield gpm: Well water was ft. after hours pumping gpm	
	Bore Hole Diameter 12 in. to 35 ft., and in. to ft.	
	WELL WATER TO BE USED AS: 5 Public water supply 8 Air conditioning 11 Injection well	
	1 Domestic 3 Feedlot 6 Oil field water supply 9 Dewatering 12 Other (Specify below)	
	2 Irrigation 4 Industrial 7 Lawn and garden only 10 Monitoring well	
	Was a chemical/bacteriological sample submitted to Department? Yes No <input checked="" type="checkbox"/> ; If yes, mo/day/yr sample was submitted	
	Water Well Disinfected? Yes <input checked="" type="checkbox"/> No	

5	TYPE OF CASING USED:	5 Wrought iron	8 Concrete tile	CASING JOINTS:	Glued <input checked="" type="checkbox"/> Clamped
	1 Steel 3 RMP (SR)	6 Asbestos-Cement	9 Other (Specify below)		Welded
	2 PVC 4 ABS	7 Fiberglass	SDR-26		Threaded
	Blank casing Diameter 5 in. to 20 ft., Dia in. to ft., Dia in. to ft.				
	Casing height above land surface 12 in., weight 2.35 lbs. / ft.			Wall thickness or gauge No. .214	
	TYPE OF SCREEN OR PERFORATION MATERIAL:	7 PVC	10 Asbestos-cement		
	1 Steel 3 Stainless Steel	5 Fiberglass	8 RMP (SR)	11 other (specify)	
	2 Brass 4 Galvanized steel	6 Concrete tile	9 ABS	12 None used (open hole)	
	SCREEN OR PERFORATION OPENING ARE:	5 Gauzed wrapped	8 Saw cut	11 None (open hole)	
	1 Continuous slot 3 Mill slot	6 Wire wrapped	9 Drilled holes		
	2 Louvered shutter 4 Key punched	7 Torch cut	10 Other (specify)		
	SCREEN-PERFORATION INTERVALS: from 20 ft. to 35 ft., From ft. to ft.				
	GRAVEL PACK INTERVALS: from 19 ft. to 35 ft., From ft. to ft.				

6	GROUT MATERIAL: 1 Neat cement	2 Cement grout	3 Bentonite	4 Other
	Grout Intervals: From 4 ft. to 24 ft., From ft. to ft.			
	What is the nearest source of possible contamination:	10 Livestock pens	14 Abandon water well	
	1 Septic tank 4 Lateral lines 7 Pit privy	11 Fuel storage	15 Oil well/Gas well	
	2 Sewer lines 5 Cess pool 8 Sewage lagoon	12 Fertilizer storage	16 Other (specify below)	
	3 Watertight sewer lines 6 Seepage pit 9 Feedyard	13 Insecticide storage		
	Direction form well? Northeast	How many feet? 150		

FROM	TO	LITHOLOGIC LOG	FROM	TO	PLUGGING INTERVALS
0	3	topsoil			
3	17	clay			
17	21	fine sand			
21	25	medium sand			
25	35	grey shale			

7	CONTRACTOR'S OR LANDOWNER'S CERTIFICATION: This water well was (1) <u>constructed</u> , (2) reconstructed, or (3) plugged under my jurisdiction and was completed on (mo/day/year) 11/09/1992 and this record is true to the best of my knowledge and belief. Kansas Water Well Contractor's License No. 236 This Water Well Record was completed on (mo/day/yr) 12/11/92 Under the business name of Harp Well & Pump Service, Inc by (signature) <i>Jane Frederick</i>
---	--