


1 LOCATION OF WATER WELL: Sumner	FRACTION SE 1/4 NE 1/4 SE 1/4	Section Number 4	Township Number T 30 S	Range Number R 1E E4W
--	---	----------------------------	----------------------------------	---------------------------------

Distance and direction from nearest town or city street address of well if located within city?

Lot 4B, Fortner Addition (3/4 m. S. of 119th, S. on Hydraulic) Peck, KS.

2 WATER WELL OWNER: IVERSON, Steve	Board of Agriculture, Division of Water Resource
RR#, ST. ADDRESS, BOX #: RR #1 Box 353	Application Number:
CITY, STATE, ZIP CODE: Peck, Kansas 67120	

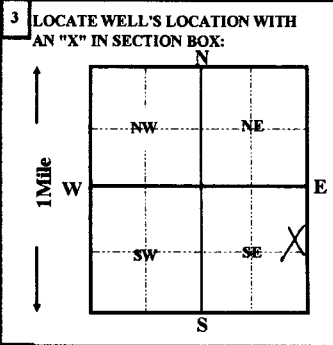

4 DEPTH OF COMPLETED WELL 33 ft.	ELEVATION:
Depth(s) groundwater Encountered 1 ft.	2 ft.
WELL'S STATIC WATER LEVEL 12 FT. BELOW LAND SURFACE MEASURED ON 05/23/1994	
Pump test data:	
Well water was	ft. after hours pumping gpm
Well water was	ft. after hours pumping gpm
Est. Yield	gpm
Bore Hole Diameter 12 in. to 33 ft.	and in. to ft.
WELL WATER TO BE USED AS:	
5 Public water supply	8 Air conditioning
11 Injection well	12 Other (Specify below)
1 Domestic	3 Feedlot
6 Oil field water supply	9 Dewatering
7 Lawn and garden only	10 Monitoring well
2 Irrigation	4 Industrial

Was a chemical/bacteriological sample submitted to Department? Yes No ; If yes, mo/day/yr sample was submitted

Water Well Disinfected? Yes No

5 TYPE OF CASING USED:	5 Wrought iron	8 Concrete tile	CASING JOINTS:
1 Steel	3 RMP (SR)	9 Other (Specify below)	Glued <input checked="" type="checkbox"/> Clamped
2 PVC	4 ABS	SDR-26	Welded
Blank casing Diameter 5 in. to 23 ft., Dia	in. to ft. , Dia	in. to ft. , Dia	Threaded
Casing height above land surface 12 in., weight 2.35 lbs./ft.	Wall thickness or gauge No. .214		
TYPE OF SCREEN OR PERFORATION MATERIAL:	7 PVC	10 Asbestos-cement	
1 Steel	3 Stainless Steel	5 Fiberglass	8 RMP (SR)
2 Brass	4 Galvanized steel	6 Concrete tile	9 ABS
SCREEN OR PERFORATION OPENING ARE:	5 Gauzed wrapped	8 Saw cut	11 None (open hole)
1 Continuous slot	3 Mill slot	6 Wire wrapped	9 Drilled holes
2 Louvered shutter	4 Key punched	7 Torch cut	10 Other (specify)
SCREEN-PERFORATION INTERVALS:	from 23 ft. to 33 ft., From	ft. to	ft.
GRAVEL PACK INTERVALS:	from 23 ft. to 33 ft., From	ft. to	ft.

6 GROUT MATERIAL:	1 Neat cement	2 Cement grout	3 Bentonite	4 Other
Grout Intervals: From 3 ft. to 23 ft. From	ft. From	ft. to	ft. From	ft. to
What is the nearest source of possible contamination:				
1 Septic tank	4 Lateral lines	7 Pit privy	10 Livestock pens	14 Abandon water well
2 Sewer lines	5 Cess pool	8 Sewage lagoon	11 Fuel storage	15 Oil well/Gas well
3 Watertight sewer lines	6 Seepage pit	9 Feedyard	12 Fertilizer storage	16 Other (specify below)
			13 Insecticide storage	

Direction from well? **Northeast** How many feet? **51**

FROM	TO	LITHOLOGIC LOG	FROM	TO	PLUGGING INTERVALS
0	3	topsoil			
3	16	clay			
16	21	fine sand			
21	27	medium sand			
27	33	grey shale			

7 CONTRACTOR'S OR LANDOWNER'S CERTIFICATION: This water well was (1) constructed , (2) reconstructed, or (3) plugged under my jurisdiction and was completed on (mo/day/year) 05/23/1994 and this record is true to the best of my knowledge and belief. Kansas Water Well Contractor's License No. 236 This Water Well Record was completed on (mo/day/yr) 06/04/94 Under the business name of Harp Well & Pump Service, Inc. by signature <i>Jane Frederick</i>
--