WATER WELL RECORD Form WWC-5 KSA 82a-1212

1 LOCATION OF WATER WELL: County: Sumner | Fraction: NW ¼ SW ¼ NW ¼ | Section Number: 10 | Township Number: T 30 S | Range Number: R 1 E/W

Distance and direction from nearest town or city? 1½ So. of Caunty Line on Hydraulic #26 | Street address of well if located within city? Greenfield Leck, Kansas

2 WATER WELL OWNER: Paul Nye Construction
RR#, St. Address, Box #: Box 6 | Spec. House
City, State, ZIP Code: Mulvane, Kansas
Board of Agriculture, Division of Water Resources Application Number:

3 DEPTH OF COMPLETED WELL 40 ft. Bore Hole Diameter 11 in. to ft., and in. to ft.

Well Water to be used as: 1 Domestic 2 Irrigation 3 Feedlot 4 Industrial 5 Public water supply 6 Oil field water supply 7 Lawn and garden only 8 Air conditioning 9 Dewatering 10 Observation well 11 Injection well 12 Other (Specify below)

Well's static water level 18 ft. below land surface measured on 4 month 22 day 1980 year

Pump Test Data: Well water was ft. after hours pumping gpm
Est. Yield gpm: Well water was ft. after hours pumping gpm

4 TYPE OF BLANK CASING USED: 1 Steel 2 PVC 3 RMP (SR) 4 ABS 5 Wrought iron 6 Asbestos-Cement 7 Fiberglass 8 Concrete tile 9 Other (specify below)

Casing Joints: Glued ✓ Clamped Welded Threaded

Blank casing dia 5 in. to 20 ft., Dia in. to ft., Dia in. to ft.
Casing height above land surface 12 in., weight lbs./ft. Wall thickness or gauge No .200

TYPE OF SCREEN OR PERFORATION MATERIAL: 1 Steel 2 Brass 3 Stainless steel 4 Galvanized steel 5 Fiberglass 6 Concrete tile 7 PVC 8 RMP (SR) 9 ABS 10 Asbestos-cement 11 Other (specify) 12 None used (open hole)

Screen or Perforation Openings Are: 1 Continuous slot 2 Louvered shutter 3 Mill slot 4 Key punched 5 Gauzed wrapped 6 Wire wrapped 7 Torch cut 8 Saw cut .06 9 Drilled holes 10 Other (specify) 11 None (open hole)

Screen-Perforation Dia 5 in. to 40 ft., Dia in. to ft., Dia in to ft.
Screen-Perforated Intervals: From 20 ft. to 40 ft., From ft. to ft.
From ft. to ft., From ft. to ft.
Gravel Pack Intervals: From 14 ft. to 40 ft., From ft. to ft.
From ft. to ft., From ft. to ft.

5 GROUT MATERIAL: 1 Neat cement 2 Cement grout 3 Bentonite 4 Other
Grouted Intervals: From 40" ± to 14 ft., From ft. to ft., From ft. to ft.

What is the nearest source of possible contamination: Septic System not installed at this time
1 Septic tank 2 Sewer lines 3 Lateral lines 4 Cess pool 5 Seepage pit 6 Pit privy 7 Sewage Lagoon 8 Feed yard 9 Livestock pens 10 Fuel storage 11 Fertilizer storage 12 Insecticide storage 13 Watertight sewer lines 14 Abandoned water well 15 Oil well/Gas well 16 Other (specify below) None apparent

Direction from well How many feet ? Water Well Disinfected? Yes ✓ No
Was a chemical/bacteriological sample submitted to Department? Yes No ✓ If yes, date sample was submitted month day year: Pump Installed? Yes No ✓
If Yes: Pump Manufacturer's name Model No. HP Volts
Depth of Pump Intake ft. Pumps Capacity rated at gal./min.
Type of pump: 1 Submersible 2 Turbine 3 Jet 4 Centrifugal 5 Reciprocating 6 Other

6 CONTRACTOR'S OR LANDOWNER'S CERTIFICATION: This water well was (1) constructed (2) reconstructed, or (3) plugged under my jurisdiction and was completed on 4 month 22 day 1980 year, and this record is true to the best of my knowledge and belief. Kansas Water Well Contractor's License No. 236
This Water Well Record was completed on 6 month 6 day 1980 year under the business name of Harp Well & Pump Serv, Inc. by (signature) M. Arnold

7 LOCATE WELL'S LOCATION WITH AN "X" IN SECTION BOX:

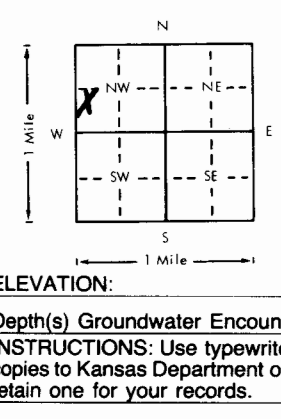

ELEVATION:

FROM	TO	LITHOLOGIC LOG	FROM	TO	LITHOLOGIC LOG
0	3	Sandy soil			
3	19	Sandy Clay			
19	28	Medium to Coarse Sand			
28	40	Blue Shale			

Depth(s) Groundwater Encountered 1. 18 ft. 2. ft. 3. ft. 4. ft. (Use a second sheet if needed)

INSTRUCTIONS: Use typewriter or ball point pen, *please press firmly* and *PRINT* clearly. Please fill in blanks, underline or circle the correct answers. Send top three copies to Kansas Department of Health and Environment, Division of Environment, Water Well Contractors, Topeka, KS 66620. Send one to WATER WELL OWNER and retain one for your records.