


WATER WELL RECORD Form WWC-5 KSA 82a-1212

1 LOCATION OF WATER WELL: County: SUMNER Fraction SE 1/4 SE 1/4 SE 1/4 Section Number 14 Township Number T 30 S Range Number R 1E EW

Distance and direction from nearest town or city street address of well if located within city? 2 1/2 miles S. of Hyway 53 on Belle Plain Rd., on W. side of Rd. Belle Plain, Ks.

2 WATER WELL OWNER: C.J. Ashmore RR#, St. Address, Box #: R #2 Box 765 City, State, ZIP Code: Mulvane, Ks. Board of Agriculture, Division of Water Resources Application Number:

3 LOCATE WELL'S LOCATION WITH AN "X" IN SECTION BOX: 4 DEPTH OF COMPLETED WELL: 40 ft. ELEVATION: ...

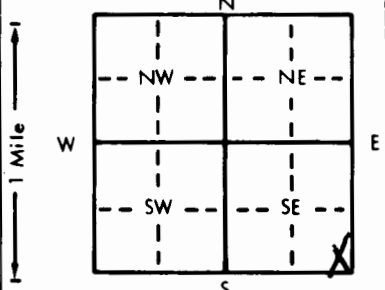

Depth(s) Groundwater Encountered 1 15 ft. 2 ft. 3 ft. WELL'S STATIC WATER LEVEL 15 ft. below land surface measured on mo/day/yr 5/6/81 Pump test data: Well water was ... ft. after ... hours pumping ... gpm Est. Yield ... gpm: Well water was ... ft. after ... hours pumping ... gpm Bore Hole Diameter 11 in. to ... ft., and ... in. to ... ft. WELL WATER TO BE USED AS: 5 Public water supply 8 Air conditioning 11 Injection well 1 Domestic 3 Feedlot 6 Oil field water supply 9 Dewatering 12 Other (Specify below) 2 Irrigation 4 Industrial 7 Lawn and garden only 10 Observation well Was a chemical/bacteriological sample submitted to Department? Yes No X; If yes, mo/day/yr sample was submitted Water Well Disinfected? Yes X No

5 TYPE OF BLANK CASING USED: 1 Steel 3 RMP (SR) 5 Wrought iron 8 Concrete tile CASING JOINTS: Glued X Clamped 2 PVC 4 ABS 6 Asbestos-Cement 9 Other (specify below) Cer-Mac Welded 7 Fiberglass SDR-26 Styrene Threaded Blank casing diameter 5 in. to 25 ft., Dia in. to ft., Dia in. to ft. Casing height above land surface 12 in., weight lbs./ft. Wall thickness or gauge No. 203 TYPE OF SCREEN OR PERFORATION MATERIAL: 1 Steel 3 Stainless steel 5 Fiberglass 8 RMP (SR) 11 Other (specify) SDR-26 2 Brass 4 Galvanized steel 6 Concrete tile 9 ABS 12 None used (open hole) SCREEN OR PERFORATION OPENINGS ARE: 1 Continuous slot 3 Mill slot 5 Gauzed wrapped 8 Saw cut .06 11 None (open hole) 2 Louvered shutter 4 Key punched 6 Wire wrapped 9 Drilled holes 7 Torch cut 10 Other (specify) SCREEN-PERFORATED INTERVALS: From 25 ft. to 40 ft. GRAVEL PACK INTERVALS: From 14 ft. to 40 ft.

6 GROUT MATERIAL: 1 Neat cement 2 Cement grout 3 Bentonite 4 Other Grout Intervals: From 40" ft. to 14 ft., From ft. to ft., From ft. to ft.

What is the nearest source of possible contamination: 1 Septic tank 4 Lateral lines 7 Pit privy 11 Fuel storage 15 Oil well/Gas well 2 Sewer lines 5 Cess pool 8 Sewage lagoon 12 Fertilizer storage 16 Other (specify below) 3 Watertight sewer lines 6 Seepage pit 9 Feedyard 13 Insecticide storage How many feet? 55

Direction from well? Southeast

FROM	TO	LITHOLOGIC LOG	FROM	TO	LITHOLOGIC LOG
0	3	Topsoil			
3	11	Clay			
11	23	Fine Sand			
23	40	Medium Sand			

7 CONTRACTOR'S OR LANDOWNER'S CERTIFICATION: This water well was (1) constructed, (2) reconstructed, or (3) plugged under my jurisdiction and was completed on (mo/day/year) 5/6/81 and this record is true to the best of my knowledge and belief. Kansas Water Well Contractor's License No. 236 This Water Well Record was completed on (mo/day/yr) 6-30-81 under the business name of Harp Well & Pump Serv., Inc. by (signature) m. Arnold

INSTRUCTIONS: Use typewriter or ball point pen, PLEASE PRESS FIRMLY and PRINT clearly. Please fill in blanks, underline or circle the correct answers. Send top three copies to Kansas Department of Health and Environment, Division of Environment, Environmental Geology Section, Topeka, KS 66620. Send one to WATER WELL OWNER and retain one for your records.