


1 LOCATION OF WATER WELL: County: Sumner Fraction: SW 1/4 SW 1/4 SW 1/4 Section Number: 15 Township Number: T 30 S Range Number: R 10 E

Distance and direction from nearest town or city street address of well, if located within city?
3 No 2 West Belle Plain Ks.

2 WATER WELL OWNER: Jim Harden
 RR#, St. Address, Box #: P.O. Box 608
 City, State, ZIP Code: Belle Plain Ks.
 Board of Agriculture, Division of Water Resources
 Application Number:

3 LOCATE WELL'S LOCATION WITH AN "X" IN SECTION BOX:

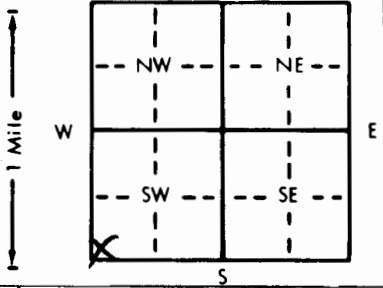

4 DEPTH OF COMPLETED WELL: 35 ft. ELEVATION:

Depth(s) Groundwater Encountered 1. 17 ft. 2. _____ ft. 3. _____ ft.
 WELL'S STATIC WATER LEVEL: 17 ft. below land surface measured on mo/day/yr 7-14-83
 Pump test data: Well water was 18 ft. after 1/2 hours pumping 10 gpm
 Est. Yield: 40 gpm; Well water was _____ ft. after _____ hours pumping _____ gpm
 Bore Hole Diameter: 11 in. to _____ ft., and _____ in. to _____ ft.

WELL WATER TO BE USED AS:
 1 Domestic 3 Feedlot 6 Oil field water supply 9 Dewatering 11 Injection well
 2 Irrigation 4 Industrial 7 Lawn and garden only 10 Observation well
 5 Public water supply 8 Air conditioning 12 Other (Specify below)

Was a chemical/bacteriological sample submitted to Department? Yes _____ No X; If yes, mo/day/yr sample was submitted _____
 Water Well Disinfected? Yes X No _____

5 TYPE OF BLANK CASING USED:
 1 Steel 3 RMP (SR) 5 Wrought iron 8 Concrete tile CASING JOINTS: Glued X Clamped _____
 2 PVC 4 ABS 6 Asbestos-Cement 9 Other (specify below) Welded _____
 _____ 7 Fiberglass Threaded _____

Blank casing diameter: 5 in. to 25 ft., Dia _____ in. to _____ ft., Dia _____ in. to _____ ft.
 Casing height above land surface: 12 in., weight 1.59 lbs./ft. Wall thickness or gauge No. SPR-26

TYPE OF SCREEN OR PERFORATION MATERIAL:
 1 Steel 3 Stainless steel 5 Fiberglass 8 RMP (SR) 10 Asbestos-cement
 2 Brass 4 Galvanized steel 6 Concrete tile 9 ABS 11 Other (specify) _____
 _____ 12 None used (open hole)

SCREEN OR PERFORATION OPENINGS ARE:
 1 Continuous slot 3 Mill slot 5 Gauzed wrapped 8 Saw cut 11 None (open hole)
 2 Louvered shutter 4 Key punched 6 Wire wrapped 9 Drilled holes
 _____ 7 Torch cut 10 Other (specify) _____

SCREEN-PERFORATED INTERVALS: From 25 ft. to 35 ft., From _____ ft. to _____ ft.
 From _____ ft. to _____ ft., From _____ ft. to _____ ft.
 GRAVEL PACK INTERVALS: From 13 ft. to 35 ft., From _____ ft. to _____ ft.
 From _____ ft. to _____ ft., From _____ ft. to _____ ft.

6 GROUT MATERIAL: 1 Neat cement 2 Cement grout 3 Bentonite 4 Other _____
 Grout Intervals: From 3 ft. to 13 ft., From _____ ft. to _____ ft., From _____ ft. to _____ ft.

What is the nearest source of possible contamination:
 1 Septic tank 4 Lateral lines 7 Pit privy 10 Livestock pens 14 Abandoned water well
 2 Sewer lines 5 Cess pool 8 Sewage lagoon 11 Fuel storage 15 Oil well/Gas well
 3 Watertight sewer lines 6 Seepage pit 9 Feedyard 12 Fertilizer storage 16 Other (specify below)
 _____ 13 Insecticide storage

Direction from well? North West. How many feet? 80.

FROM	TO	LITHOLOGIC LOG	FROM	TO	LITHOLOGIC LOG
0	2	Top soil			
2	15	gray clay			
15	28	gravel			
28	35	Blue shale			

7 CONTRACTOR'S OR LANDOWNER'S CERTIFICATION: This water well was (1) constructed, (2) reconstructed, or (3) plugged under my jurisdiction and was completed on (mo/day/year) 7-14-83 and this record is true to the best of my knowledge and belief. Kansas Water Well Contractor's License No. 318 This Water Well Record was completed on (mo/day/yr) 7-14-83 under the business name of Weninger Drilling by (signature) [Signature]

INSTRUCTIONS: Use typewriter or ball point pen, PLEASE PRESS FIRMLY and PRINT clearly. Please fill in blanks, underline or circle the correct answers. Send top three copies to Kansas Department of Health and Environment, Division of Environment, Environmental Geology Section, Topeka, KS 66620. Send one to WATER WELL OWNER and retain one for your records.