


1 LOCATION OF WATER WELL: County: SUMNER Fraction: SW 1/4 SE 1/4 SW 1/4 Section Number: 16 Township Number: T 30 S Range Number: R 1 EW

Distance and direction from nearest town or city street address of well if located within city?
2 MILE EAST - 2 MILE SOUTH 1/4 MILE EAST OF PECK, KS 67120

2 WATER WELL OWNER: GENE BONGIORNI
 RR#, St. Address, Box #: BOX 121 Board of Agriculture, Division of Water Resources
 City, State, ZIP Code: PECK, KS 67120 Application Number:

3 LOCATE WELL'S LOCATION WITH AN "X" IN SECTION BOX:

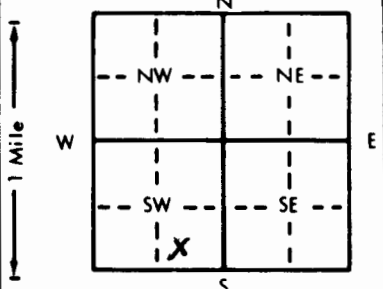

4 DEPTH OF COMPLETED WELL: 30 ft. ELEVATION:

Depth(s) Groundwater Encountered 1. 15 ft. 2. 15 ft. 3. 15 ft.
 WELL'S STATIC WATER LEVEL 15 ft. below land surface measured on mo/day/yr 5-19-92
 Pump test data: Well water was 15 ft. after 2 hours pumping 30 gpm
 Est. Yield 40 gpm: Well water was 15 ft. after 2 hours pumping 30 gpm
 Bore Hole Diameter 11 in. to 30 ft., and 30 in. to 30 ft.
 WELL WATER TO BE USED AS:
 1 Domestic 3 Feedlot 6 Oil field water supply 9 Dewatering 12 Other (Specify below)
 2 Irrigation 4 Industrial 7 Lawn and garden only 10 Monitoring well
 Was a chemical/bacteriological sample submitted to Department? Yes No ; If yes, mo/day/yr sample was submitted
 Water Well Disinfected? Yes No

5 TYPE OF BLANK CASING USED:

1 Steel 3 RMP (SR) 5 Wrought iron 8 Concrete tile CASING JOINTS: Glued Clamped
 2 PVC 4 ABS 6 Asbestos-Cement 9 Other (specify below) Welded
 Blank casing diameter 3 in. to 21 ft., Dia in. to ft., Dia in. to ft.
 Casing height above land surface 12 in., weight 237 lbs./ft. Wall thickness or gauge No. 250
 TYPE OF SCREEN OR PERFORATION MATERIAL:
 7 PVC 10 Asbestos-cement
 1 Steel 3 Stainless steel 5 Fiberglass 8 RMP (SR) 11 Other (specify)
 2 Brass 4 Galvanized steel 6 Concrete tile 9 ABS 12 None used (open hole)

SCREEN OR PERFORATION OPENINGS ARE:
 1 Continuous slot 3 Mill slot 5 Gauzed wrapped 8 Saw cut 11 None (open hole)
 2 Louvered shutter 4 Key punched 6 Wire wrapped 9 Drilled holes
 7 Torch cut 10 Other (specify)

SCREEN-PERFORATED INTERVALS: From 21 ft. to 30 ft., From ft. to ft., From ft. to ft.
 GRAVEL PACK INTERVALS: From 20 ft. to 30 ft., From ft. to ft., From ft. to ft.

6 GROUT MATERIAL: Neat cement 2 Cement grout 3 Bentonite 4 Other
 Grout Intervals: From 0 ft. to 15 ft., From 15 ft. to 20 ft., From ft. to ft.

What is the nearest source of possible contamination:
 1 Septic tank 4 Lateral lines 7 Pit privy 10 Livestock pens 14 Abandoned water well
 2 Sewer lines 5 Cess pool 8 Sewage lagoon 11 Fuel storage 15 Oil well/Gas well
 3 Watertight sewer lines 6 Seepage pit 9 Feedyard 12 Fertilizer storage 16 Other (specify below)
 13 Insecticide storage

Direction from well? SOUTH EAST How many feet? 200

FROM	TO	LITHOLOGIC LOG	FROM	TO	PLUGGING INTERVALS
0	2	SURFACE SOIL			
2	14	CLAY			
14	20	FINE SAND			
20	30	COURSE SAND			

7 CONTRACTOR'S OR LANDOWNER'S CERTIFICATION: This water well was (1) constructed, (2) reconstructed, or (3) plugged under my jurisdiction and was completed on (mo/day/year) 5-19-92 and this record is true to the best of my knowledge and belief. Kansas Water Well Contractor's License No. 437 This Water Well Record was completed on (mo/day/yr) 5-28-92 under the business name of ALPH METZGER WELL DIGGER DRILLING Alph Metzger