


WATER WELL RECORD Form WWC-5 KSA 82a-1212

1 LOCATION OF WATER WELL: County: Sumner Fraction: SE 1/4 SE 1/4 SW 1/4 Section Number: 19 Township Number: T 30 S Range Number: R 1E **(EW)**

Distance and direction from nearest town or city street address of well if located within city?
3 miles S. of 119th So., 1 3/4 West of Broadway, 1 mile So.. 1/4 East Peck, Ks.

2 WATER WELL OWNER: Wayland R. Buller
 RR#, St. Address, Box #: 218 Sarah Land Board of Agriculture, Division of Water Resources
 City, State, ZIP Code: Haysville, Ks. Application Number:

3 LOCATE WELL'S LOCATION WITH AN "X" IN SECTION BOX:

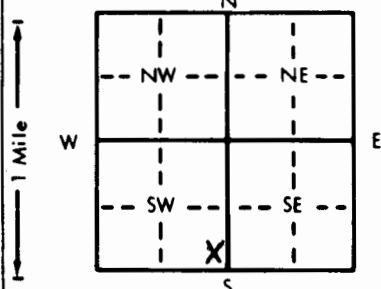

4 DEPTH OF COMPLETED WELL: 30 ft. ELEVATION:

Depth(s) Groundwater Encountered 1. 16 ft. 2. . ft. 3. . ft.
 WELL'S STATIC WATER LEVEL 16 ft. below land surface measured on mo/day/yr 9-28-88
 Pump test data: Well water was . ft. after . hours pumping . gpm
 Est. Yield . gpm: Well water was . ft. after . hours pumping . gpm
 Bore Hole Diameter: 11 in. to . ft., and . in. to . ft.
 WELL WATER TO BE USED AS:
 1 Domestic 3 Feedlot 6 Oil field water supply 9 Dewatering 12 Other (Specify below)
 2 Irrigation 4 Industrial 7 Lawn and garden only 10 Monitoring well
 Was a chemical/bacteriological sample submitted to Department? Yes. . No. X .; If yes, mo/day/yr sample was submitted
 Water Well Disinfected? Yes X No

5 TYPE OF BLANK CASING USED:

1 Steel 3 RMP (SR) 5 Wrought iron 8 Concrete tile CASING JOINTS: Glued . . Clamped .
 2 PVC 4 ABS 6 Asbestos-Cement 9 Other (specify below) Welded .
 Blank casing diameter 5 in. to 24 ft., Dia. 1.59 in. to . ft., Dia. . in. to 203 ft.
 Casing height above land surface: 12 in., weight . lbs./ft. Wall thickness or gauge No. .

TYPE OF SCREEN OR PERFORATION MATERIAL:

1 Steel 3 Stainless steel 5 Fiberglass 8 RMP (SR) 11 Other (specify) .
 2 Brass 4 Galvanized steel 6 Concrete tile 9 ABS 12 None used (open hole)
 SCREEN OR PERFORATION OPENINGS ARE:
 1 Continuous slot 3 Mill slot 5 Gauzed wrapped 8 Saw cut 11 None (open hole)
 2 Louvered shutter 4 Key punched 6 Wire wrapped 9 Drilled holes
 7 Torch cut 10 Other (specify) .

SCREEN-PERFORATED INTERVALS: From 24 ft. to 30 ft., From . ft. to . ft.
 From . ft. to . ft., From . ft. to . ft.
 GRAVEL PACK INTERVALS: From 24 ft. to 30 ft., From . ft. to . ft.
 From . ft. to . ft., From . ft. to . ft.

6 GROUT MATERIAL: 1 Neat cement 2 Cement grout 3 Bentonite 4 Other .

Grout Intervals: From 4 ft. to 24 ft., From . ft. to . ft., From . ft. to . ft.
 What is the nearest source of possible contamination:
 1 Septic tank 4 Lateral lines 7 Pit privy 10 Livestock pens 14 Abandoned water well
 2 Sewer lines 5 Cess pool 8 Sewage lagoon 11 Fuel storage 15 Oil well/Gas well
 3 Watertight sewer lines 6 Seepage pit 9 Feedyard 12 Fertilizer storage 16 Other (specify below)
 13 Insecticide storage
 Direction from well? S.E. How many feet? 80

| FROM | TO | LITHOLOGIC LOG | FROM | TO | PLUGGING INTERVALS |
|------|----|----------------|------|----|--------------------|
| 0 | 3 | topsoil | | | |
| 3 | 23 | fine sand | | | |
| 23 | 30 | medium sand | | | |
| | | | | | |
| | | | | | |
| | | | | | |
| | | | | | |
| | | | | | |
| | | | | | |
| | | | | | |

7 CONTRACTOR'S OR LANDOWNER'S CERTIFICATION: This water well was (1) constructed, (2) reconstructed, or (3) plugged under my jurisdiction and was completed on (mo/day/year) 9-28-88 and this record is true to the best of my knowledge and belief. Kansas Water Well Contractor's License No. 236 This Water Well Record was completed on (mo/day/yr) 4-24-89 under the business name of Harp Well and Pump Service, Inc. by signature Mary Arnold

INSTRUCTIONS: Use typewriter or ball point pen. PLEASE PRESS FIRMLY and PRINT clearly. Please fill in blanks, underline or circle the correct answers. Send top three copies to Kansas Department of Health and Environment, Bureau of Water Protection, Topeka, Kansas 66620-7320. Telephone: 913-296-5514. Send one to WATER WELL OWNER and retain one for your records.