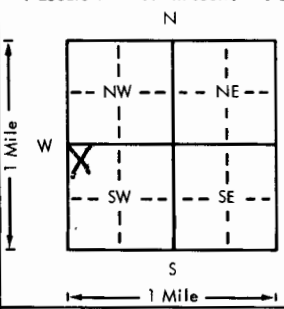


USE TYPEWRITER OR BALL POINT PEN-PRESS FIRMLY, PRINT CLEARLY.

WATER WELL RECORD  
KSA 82a-1201-1215

Kansas Department of Health and Environment-Division of Environment (Water well Contractors) Topeka, Kansas 66620

1. Location of well: County <u>Sumner</u> Fraction <u>NW 1/4 NW 1/4 SW 1/4</u> Section number <u>29</u> Township number T <u>30</u> S R <u>1</u> <u>GW</u>	
2. Distance and direction from nearest town or city: <u>2 1/2 mi. North</u> 3. Owner of well: <u>Darrell Hauserman</u> Street address of well location if in city: <u>Bel Plaine</u> R.R. or street: <u>1319 Hydraulic S.</u> City, state, zip code: <u>Wichita Kans</u>	
4. Locate with "X" in section below: Sketch map: 	
5. Type and color of material	
	From To
<u>Brown Sand Fine</u>	<u>0</u> <u>2</u>
<u>Gray Sand Fine</u>	<u>2</u> <u>11</u>
<u>White Sand Coarse</u>	<u>11</u> <u>22</u>
<u>Pea Gravel white + Brown</u>	<u>22</u> <u>30</u>
(Use a second sheet if needed)	
6. Bore hole dia. <u>8</u> in. Completion date <u>8/8/77</u> Well depth <u>30</u> ft.	7. Cable tool <input checked="" type="checkbox"/> Rotary <input type="checkbox"/> Driven <input type="checkbox"/> Dug <input type="checkbox"/> Hollow rod <input type="checkbox"/> Jetted <input type="checkbox"/> Bored <input type="checkbox"/> Reverse rotary
8. Use: <input checked="" type="checkbox"/> Domestic <input type="checkbox"/> Public supply <input type="checkbox"/> Industry <input type="checkbox"/> Irrigation <input type="checkbox"/> Air conditioning <input type="checkbox"/> Stock <input type="checkbox"/> Lawn <input type="checkbox"/> Oil field water <input type="checkbox"/> Other	
9. Casing: Material <u>Stycere</u> Height: Above or below Threaded <input type="checkbox"/> Welded <input type="checkbox"/> Surface <u>72</u> in. RMP <input checked="" type="checkbox"/> PVC <input type="checkbox"/> Weight <u>100</u> lbs./ft. Dia. <u>6</u> in. to <u>30</u> ft. depth Wall Thickness: inches or Dia. <u>  </u> in. to <u>  </u> ft. depth gage No. <u>100</u>	
10. Screen: Manufacturer's name <u>Sunflower</u> Type <u>100</u> Dia. <u>5"</u> Slot/gauze <u>slot</u> Length <u>5'</u> Set between <u>25</u> ft. and <u>30</u> ft. Gravel pack <u>4/0</u> Size range of material <u>  </u> ft. and <u>  </u> ft.	
11. Static water level: <u>11</u> ft. below land surface Date <u>8/8/77</u> mo./day/yr.	
12. Pumping level below land surfaces: <u>  </u> ft. after <u>  </u> hrs. pumping <u>  </u> g.p.m. <u>  </u> ft. after <u>  </u> hrs. pumping <u>  </u> g.p.m. Estimated maximum yield <u>10</u> g.p.m.	
13. Water sample submitted: <u>  </u> mo./day/yr. <input type="checkbox"/> Yes <input checked="" type="checkbox"/> No Date <u>  </u>	
14. Well head completion: <input type="checkbox"/> Pitless adapter <u>12</u> Inches above grade	
15. Well grouted? <u>yes</u> With: <input checked="" type="checkbox"/> Neat cement <input type="checkbox"/> Bentonite <input type="checkbox"/> Concrete Depth: From <u>0</u> ft. to <u>10</u> ft.	
16. Nearest source of possible contamination: ft. <u>50</u> Direction <u>WEST</u> Type <u>Sewer</u> Well disinfected upon completion? <input checked="" type="checkbox"/> Yes <input type="checkbox"/> No	
17. Pump: <input checked="" type="checkbox"/> Not installed Manufacturer's name <u>  </u> Model number <u>  </u> HP <u>  </u> Volts <u>  </u> Length of drop pipe <u>  </u> ft. capacity <u>  </u> g.p.m. Type: <input type="checkbox"/> Submersible <input type="checkbox"/> Turbine <input type="checkbox"/> Jet <input type="checkbox"/> Reciprocating <input type="checkbox"/> Centrifugal <input type="checkbox"/> Other	
18. Elevation:  Topography: <input type="checkbox"/> Hill <input type="checkbox"/> Slope <input type="checkbox"/> Upland <input checked="" type="checkbox"/> Valley	19. Remarks:  20. Water well contractor's certification: This well was drilled under my jurisdiction and this report is true to the best of my knowledge and belief. <u>Jet Drilling 313</u> Business name <u>257 N. Salina</u> License No. <u>  </u> Address <u>Wichita</u> Signed <u>Darrell Hauserman</u> Date <u>8/8/77</u> Authorized representative

30-1W 22 NW 1/4 SW 1/4