


1 LOCATION OF WATER WELL: Sumner	FRACTION NW 1/4 NW 1/4 SW 1/4	Section Number 25	Township Number T 30 S	Range Number R 1E E/W
--	---	-----------------------------	----------------------------------	---------------------------------

Distance and direction from nearest town or city street address of well if located within city?
1 mile North of Belle Plaine Belle Plaine, Kansas

2 WATER WELL OWNER: BRIBACH, Gene RR#, ST. ADDRESS, BOX #: Rt. 1 Box 10 CITY, STATE, ZIP CODE: Belle Plaine, Kansas 67013	Board of Agriculture, Division of Water Resource Application Number: _____
--	---

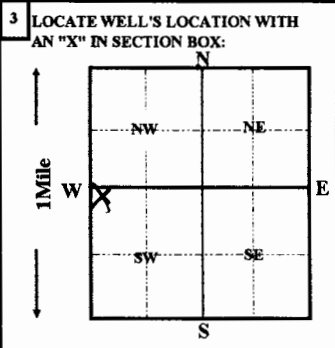

4 DEPTH OF COMPLETED WELL 40 ft. ELEVATION: Depth(s) groundwater Encountered 1 ft. 2 ft. 3 ft. ft.	WELL'S STATIC WATER LEVEL 15 FT. BELOW LAND SURFACE MEASURED ON mo/day/yr 08/19/1993
Pump test data: Well water was ft. after hours pumping gpm	
Est. Yield gpm: Well water was ft. after hours pumping gpm	
Bore Hole Diameter 12 in. to 40 ft., and in. to ft.	
WELL WATER TO BE USED AS: 5 Public water supply 8 Air conditioning 11 Injection well	
1 Domestic 3 Feedlot 6 Oil field water supply 9 Dewatering 12 Other (Specify below)	
2 Irrigation 4 Industrial 7 Lawn and garden only 10 Monitoring well	
Was a chemical/bacteriological sample submitted to Department? Yes No X ; If yes, mo/day/yr sample was submitted _____	
Water Well Disinfected? Yes X No	

5 TYPE OF CASING USED: 1 Steel 3 RMP (SR) 2 PVC 4 ABS Blank casing Diameter 5 in. to 20 ft., Dia in. to ft. Casing height above land surface 12 in., weight 2.35 lbs. / ft. TYPE OF SCREEN OR PERFORATION MATERIAL: 1 Steel 3 Stainless Steel 5 Fiberglass 2 Brass 4 Galvanized steel 6 Concrete tile	5 Wrought iron 8 Concrete tile CASING JOINTS: Glued X Clamped 6 Asbestos-Cement 9 Other (Specify below) Welded 7 Fiberglass SDR-26 Threaded 8 RMP (SR) 10 Asbestos-cement 9 ABS 11 other (specify) 12 None used (open hole) SCREEN OR PERFORATION OPENING ARE: 5 Gauzed wrapped 8 Saw cut 11 None (open hole) 1 Continous slot 3 Mill slot 6 Wire wrapped 9 Drilled holes 2 Louvered shutter 4 Key punched 7 Torch cut 10 Other (specify) SCREEN-PERFORATION INTERVALS: from 20 ft. to 40 ft., From ft. to ft. from ft. to ft., From ft. to ft. GRAVEL PACK INTERVALS: from 20 ft. to 40 ft., From ft. to ft. from ft. to ft., From ft. to ft.
--	---

6 GROUT MATERIAL: 1 Neat cement 2 Cement grout 3 Bentonite 4 Other Grout Intervals: From 0 ft. to 20 ft., From ft. to ft.	10 Livestock pens 14 Abandon water well 1 Septic tank 4 Lateral lines 7 Pit privy 11 Fuel storage 15 Oil well/Gas well 2 Sewer lines 5 Cess pool 8 Sewage lagoon 12 Fertilizer storage 16 Other (specify below) 3 Watertight sewer lines 6 Seepage pit 9 Feedyard 13 Insecticide storage None Apparent
--	--

Direction from well? _____ How many feet? _____

FROM	TO	LITHOLOGIC LOG	FROM	TO	PLUGGING INTERVALS
0	3	topsoil			
3	14	clay			
14	25	fine sand			
25	40	medium sand			

7 CONTRACTOR'S OR LANDOWNER'S CERTIFICATION: This water well was (1) constructed, (2) reconstructed, or (3) plugged under my jurisdiction and was completed on (mo/day/year) 08/19/1993 and this record is true to the best of my knowledge and belief. Kansas Water Well Contractor's License No. 236 This Water Well Record was completed on (mo/day/yr) 08/31/93 Under the business name of Harp Well & Pump Service, Inc by (signature) <i>Jane Frederick</i>	626
--	-----