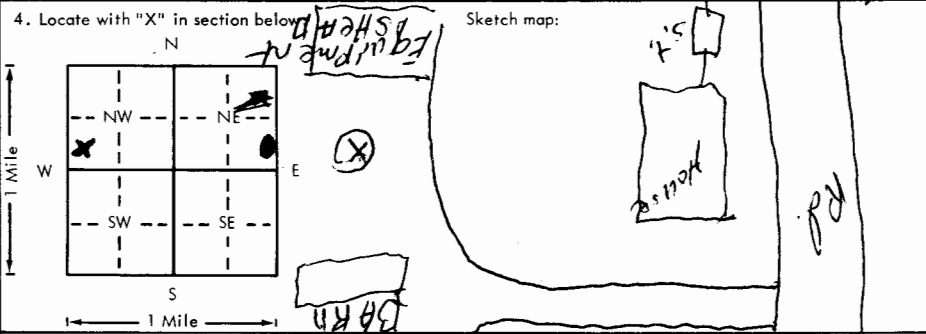


USE TYPEWRITER OR BALL POINT PEN-PRESS FIRMLY, PRINT CLEARLY.

WATER WELL RECORD  
KSA 82a-1201-1215

Kansas Department of Health and Environment-Division of Environment  
(Water well Contractors)  
Topeka, Kansas 66620

1. Location of well: County <b>Summer</b> Fraction <b>SW 1/4 NW 1/4 NW 1/4</b> Section number <b>26</b> Township number <b>T 30 S R 1</b> Range number <b>EW</b>	
2. Distance and direction from nearest town or city: <b>3 No. of Belle Plaine, Ks.</b> 3. Owner of well: <b>Clyde J. Brown</b> R.R. or street: <b>pt 1</b> City, state, zip code: <b>Belle Plaine KS 67013</b>	
4. Locate with "X" in section below: 	
5. Type and color of material	
TOP SOIL	From 0 To 3
Red CLAY	3 10
SAND + Gravel	10 40
6. Bore hole dia. <b>11 3/4</b> in. Completion date <b>6-3-78</b> Well depth <b>40</b> ft.	
7. <input checked="" type="checkbox"/> Cable tool <input checked="" type="checkbox"/> Rotary <input type="checkbox"/> Driven <input type="checkbox"/> Dug <input type="checkbox"/> Hollow rod <input type="checkbox"/> Jetted <input type="checkbox"/> Bored <input type="checkbox"/> Reverse rotary	
8. Use: <input type="checkbox"/> Domestic <input type="checkbox"/> Public supply <input type="checkbox"/> Industry <input checked="" type="checkbox"/> Irrigation <input type="checkbox"/> Air conditioning <input type="checkbox"/> Stock <input checked="" type="checkbox"/> Lawn <input type="checkbox"/> Oil field water <input type="checkbox"/> Other	
9. Casing: Material <b>PVC</b> Height: <b>Above</b> or below Threaded <input type="checkbox"/> Welded <input type="checkbox"/> Surface <b>18</b> in. RMP <b>PVC</b> <b>GL</b> Weight <b>10</b> lbs./ft. Dia. <b>5</b> in. to <b>30</b> ft. depth Wall Thickness: inches or Dia. <b>5</b> in. to <b>30</b> ft. depth Gauge No. <b>250</b>	
10. Screen: Manufacturer's name <b>M.P.I.</b> Type <b>P.V.C.</b> Dia. <b>5</b> Slot gauge <b>25/1000</b> Length <b>10</b> Set between <b>30</b> ft. and <b>40</b> ft. ft. and <b>40</b> ft. Gravel pack? <b>yes</b> Size range of material <b>1/4 to 3/8</b>	
11. Static water level: <b>11</b> ft. below land surface Date <b>6-3-78</b> mo./day/yr.	
12. Pumping level below land surfaces: <b>70 + 30 Volamin</b> → ____ ft. after ____ hrs. pumping ____ g.p.m. ____ ft. after ____ hrs. pumping ____ g.p.m. Estimated maximum yield <b>UNLIMITED</b> g.p.m.	
13. Water sample submitted: <b>5-3-78</b> mo./day/yr. <input type="checkbox"/> Yes <input checked="" type="checkbox"/> No Date <b>5-3-78</b>	
14. Well head completion: <input type="checkbox"/> Pitless adapter <b>18</b> Inches above grade	
15. Well grouted? <b>yes</b> With: <input checked="" type="checkbox"/> Neat cement <input type="checkbox"/> Bentonite <input type="checkbox"/> Concrete Depth: From <b>0</b> ft. to <b>10</b> ft.	
16. Nearest source of possible contamination: ft. <b>250</b> Direction <b>E</b> Type <b>s.t.</b> Well disinfected upon completion? <input checked="" type="checkbox"/> Yes <input type="checkbox"/> No	
17. Pump: <input checked="" type="checkbox"/> Not installed Manufacturer's name _____ Model number _____ HP _____ Volts _____ Length of drop pipe _____ ft. capacity _____ g.p.m. Type: <input type="checkbox"/> Submersible <input type="checkbox"/> Turbine <input type="checkbox"/> Jet <input type="checkbox"/> Reciprocating <input type="checkbox"/> Centrifugal <input type="checkbox"/> Other	
(Use a second sheet if needed)	
18. Elevation:	19. Remarks: <b>Clyde is going to complete the well and install Pump Run slope concrete. Clyde J. Brown</b>
Topography: <input type="checkbox"/> Hill <input type="checkbox"/> Slope <input checked="" type="checkbox"/> Upland <input type="checkbox"/> Valley	20. Water well contractor's certification: This well was drilled under my jurisdiction and this report is true to the best of my knowledge and belief. <b>P. Reid Construction</b> Business name <b>Box 714</b> License No. <b>353</b> Address <b>Austin C. Reid</b> Date <b>6-3-78</b> Signed _____ Authorized representative

30 1-0-78  
Sec 1/4 1/4 1/4 1/4  
Summer