


1 LOCATION OF WATER WELL: County: SUMNER Fraction: SW 1/4 SE 1/4 SE 1/4 Section Number: 31 Township Number: T 30 S Range Number: R 1 E/W

Distance and direction from nearest town or city street address of well if located within city: 3 West Belle Plume KS.

2 WATER WELL OWNER: Ronald Willford  
 RR#, St. Address, Box #: 2342 So Bedford  
 City, State, ZIP Code: Wichita KS 67207  
 Board of Agriculture, Division of Water Resources  
 Application Number:

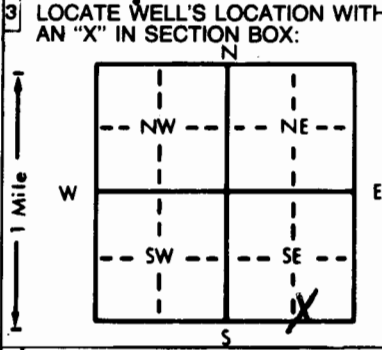

4 DEPTH OF COMPLETED WELL: 65 ft. ELEVATION: ..... ft.  
 Depth(s) Groundwater Encountered 1. 25 ft. 2. .... ft. 3. .... ft.  
 WELL'S STATIC WATER LEVEL: 17 ft. below land surface measured on mo/day/yr: 8-11-86  
 Pump test data: Well water was 20 ft. after 20 hours pumping 20 gpm  
 Est. Yield 20 gpm: Well water was ..... ft. after ..... hours pumping ..... gpm  
 Bore Hole Diameter: 11 in. to 65 ft., and ..... in. to ..... ft.  
 WELL WATER TO BE USED AS:  
 5 Public water supply 8 Air conditioning 11 Injection well  
 1 Domestic 3 Feedlot 6 Oil field water supply 9 Dewatering 12 Other (Specify below)  
 2 Irrigation 4 Industrial 7 Lawn and garden only 10 Observation well  
 Was a chemical/bacteriological sample submitted to Department? Yes.....No.....X; If yes, mo/day/yr sample was submitted  
 Water Well Disinfected? Yes X No

5 TYPE OF BLANK CASING USED:  
 1 Steel 3 RMP (SR)  
 2 PVC 4 ABS  
 Blank casing diameter: 5 in. to 15 ft., Dia. .... in. to .... ft., Dia. .... in. to .... ft.  
 Casing height above land surface: 12 in., weight 1.59 lbs./ft. Wall thickness or gauge No. 502-26  
 TYPE OF SCREEN OR PERFORATION MATERIAL:  
 1 Steel 3 Stainless steel 5 Fiberglass 8/RMP (SR)  
 2 Brass 4 Galvanized steel 6 Concrete tile 9 ABS 12 None used (open hole)  
 SCREEN OR PERFORATION OPENINGS ARE:  
 1 Continuous slot 3 Mill slot  
 2 Louvered shutter 4 Key punched  
 SCREEN-PERFORATED INTERVALS: From 15 ft. to 65 ft., From ..... ft. to ..... ft.  
 GRAVEL PACK INTERVALS: From 13 ft. to 65 ft., From ..... ft. to ..... ft.

6 GROUT MATERIAL: 1 Neat cement 2 Cement grout 3 Bentonite 4 Other .....  
 Grout Intervals: From 3 ft. to 13 ft., From ..... ft. to ..... ft., From ..... ft. to ..... ft.  
 What is the nearest source of possible contamination:  
1 Septic tank 4 Lateral lines 7 Pit privy 10 Livestock pens 14 Abandoned water well  
 2 Sewer lines 5 Cess pool 8 Sewage lagoon 11 Fuel storage 15 Oil well/Gas well  
 3 Watertight sewer lines 6 Seepage pit 9 Feedyard 12 Fertilizer storage 16 Other (specify below)  
 13 Insecticide storage  
 Direction from well? NE How many feet? 150

FROM	TO	LITHOLOGIC LOG	FROM	TO	LITHOLOGIC LOG
0	2	top soil			
2	14	clay			
14	65	charred shale			

7 CONTRACTOR'S OR LANDOWNER'S CERTIFICATION: This water well was (1) constructed, (2) reconstructed, or (3) plugged under my jurisdiction and was completed on (mo/day/year) 8-11-86 and this record is true to the best of my knowledge and belief. Kansas Water Well Contractor's License No. 318 this Water Well-Record was completed on (mo/day/yr) 8-25-86 under the business name of Wanninger Pully by (signature) [Signature]

INSTRUCTIONS: Use typewriter or ball point pen. PLEASE PRESS FIRMLY and PRINT clearly. Please fill in blanks, underline or circle the correct answers. Send top three copies to Kansas Department of Health and Environment, Office of Oil Field and Environmental Geology, Regulation and Permitting Section, Topeka, Kansas 66620-7500, Telephone: 913-862-9360. Send one to WATER WELL OWNER and retain one for your records.