


1 LOCATION OF WATER WELL: County: SUMNER Fraction: ~~SW~~ NW SW Section Number: 32 Township Number: T 30 S Range Number: R 1 E EW

Distance and direction from nearest town or city street address of well if located within city? 3/4 West of Belle Plaine Y, 1/2 North, West side River. Belle Plaine, KS.

2 WATER WELL OWNER: Roger Grady RR#, St. Address, Box #: Belle Plaine, KS. Board of Agriculture, Division of Water Resources Application Number:

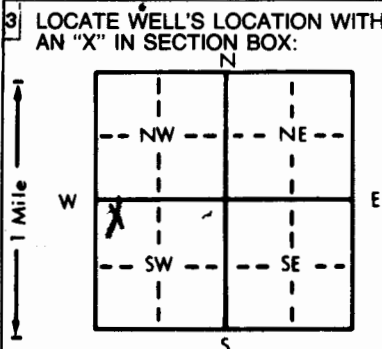

4 DEPTH OF COMPLETED WELL: 45 ft. ELEVATION: ... WELL'S STATIC WATER LEVEL: 17 ft. below land surface measured on mo/day/yr 11-5-87. Pump test data: Well water was ... ft. after ... hours pumping ... gpm. Est. Yield ... gpm: Well water was ... ft. after ... hours pumping ... gpm. Bore Hole Diameter: 11 in. to ... ft., and ... in. to ... ft. WELL WATER TO BE USED AS: 5 Public water supply 8 Air conditioning 11 Injection well 1 Domestic 3 Feedlot 6 Oil field water supply 9 Dewatering 12 Other (Specify below) 2 Irrigation 4 Industrial 7 Lawn and garden only 10 Monitoring well. Was a chemical/bacteriological sample submitted to Department? Yes.....No.....x.....; If yes, mo/day/yr sample was submitted Water Well Disinfected? Yes x No

5 TYPE OF BLANK CASING USED: 1 Steel 2 PVC 3 RMP (SR) 4 ABS 5 Wrought iron 6 Asbestos-Cement 7 Fiberglass 8 Concrete tile 9 Other (specify below) Cer-Mac styren SDR-26 CASING JOINTS: Glued S Clamped Welded Threaded. Blank casing diameter: 5 in. to 30 ft., Dia. Casing height above land surface: 12 in., weight 1.59 lbs./ft. Wall thickness or gauge No. 203. TYPE OF SCREEN OR PERFORATION MATERIAL: 1 Steel 2 Brass 3 Stainless steel 4 Galvanized steel 5 Fiberglass 6 Concrete tile 7 PVC 8 RMP (SR) 9 ABS 10 Asbestos-cement 11 Other (specify) 12 None used (open hole). SCREEN OR PERFORATION OPENINGS ARE: 1 Continuous slot 2 Louvered shutter 3 Mill slot 4 Key punched 5 Gauzed wrapped 6 Wire wrapped 7 Torch cut 8 Saw cut 9 Drilled holes 11 None (open hole). SCREEN-PERFORATED INTERVALS: From 30 ft. to 45 ft. GRAVEL PACK INTERVALS: From 24 ft. to 45 ft.

6 GROUT MATERIAL: 1 Neat cement 2 Cement grout 3 Bentonite 4 Other. Grout Intervals: From 4 ft. to 24 ft. What is the nearest source of possible contamination: 1 Septic tank 2 Sewer lines 3 Watertight sewer lines 4 Lateral lines 5 Cess pool 6 Seepage pit 7 Pit privy 8 Sewage lagoon 9 Feedyard 10 Livestock pens 11 Fuel storage 12 Fertilizer storage 13 Insecticide storage 14 Abandoned water well 15 Oil well/Gas well 16 Other (specify below) None apparent.

Direction from well? How many feet? Table with columns: FROM, TO, LITHOLOGIC LOG, FROM, TO, PLUGGING INTERVALS. Data: 0-3 Topsoil, 3-28 Clay, 18-31 Fine Sand, 31-45 Medium Sand.

7 CONTRACTOR'S OR LANDOWNER'S CERTIFICATION: This water well was (1) constructed, (2) reconstructed, or (3) plugged under my jurisdiction and was completed on (mo/day/year) 11-5-87 and this record is true to the best of my knowledge and belief. Kansas Water Well Contractor's License No. 236 This Water Well Record was completed on (mo/day/yr) 6-10-88 under the business name of Harp Well & Pump Service, Inc. by (signature) Mary Arnold