


1 LOCATION OF WATER WELL: Fraction SE SE Section Number 32 Township Number T 30 S Range Number R 1 E  
 County: SUMNER NW 1/4 ~~SW 1/4~~ ~~SE 1/4~~

Distance and direction from nearest town or city street address of well if located within city?  
3 MILE EAST OF BOLLER PLAINS KANSAS

2 WATER WELL OWNER: JOE SWISHER  
 RR#, St. Address, Box #: ROUTE 2 Board of Agriculture, Division of Water Resources  
 City, State, ZIP Code: BOLLER PLAINS, KANSAS 67013 Application Number:

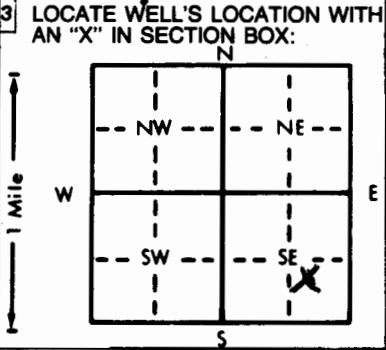

4 DEPTH OF COMPLETED WELL: 35 ft. ELEVATION:  
 Depth(s) Groundwater Encountered 1. 19 ft. 2. 19 ft. 3. 19 ft.  
 WELL'S STATIC WATER LEVEL: 19 ft. below land surface measured on mo/day/yr 4-13-87  
 Pump test data: Well water was 19 ft. after 2 hours pumping 20 gpm  
 Est. Yield 40 gpm: Well water was 19 ft. after 2 hours pumping 20 gpm  
 Bore Hole Diameter: 10 in. to 35 ft., and 35 ft. to 35 ft.  
 WELL WATER TO BE USED AS:  
 1 Domestic  3 Feedlot  6 Oil field water supply  9 Dewatering  12 Other (Specify below)  
 2 Irrigation  4 Industrial  7 Lawn and garden only  10 Observation well  
 Was a chemical/bacteriological sample submitted to Department? Yes  No  If yes, mo/day/yr sample was submitted  
 Water Well Disinfected? Yes  No

5 TYPE OF BLANK CASING USED:  
 1 Steel  3 RMP (SR)  5 Wrought iron  8 Concrete tile CASING JOINTS: Glued  Clamped  
 2 PVC  4 ABS  6 Asbestos-Cement  9 Other (specify below) Welded   
 7 Fiberglass Threaded   
 Casing height above land surface 16 in., weight 2.37 lbs./ft. Wall thickness or gauge No. 250  
 TYPE-OF SCREEN OR PERFORATION MATERIAL:  
 1 Steel  3 Stainless steel  5 Fiberglass  8 RMP (SR)  10 Asbestos-cement  
 2 Brass  4 Galvanized steel  6 Concrete tile  9 ABS  11 Other (specify)  12 None used (open hole)  
 SCREEN OR PERFORATION OPENINGS ARE:  
 1 Continuous slot  3 Mill slot  5 Gauzed wrapped  8 Saw cut  11 None (open hole)  
 2 Louvered shutter  4 Key punched  6 Wire wrapped  9 Drilled holes  
 7 Torch cut  10 Other (specify)   
 SCREEN-PERFORATED INTERVALS: From 23 ft. to 35 ft., From 23 ft. to 35 ft., From 23 ft. to 35 ft., From 23 ft. to 35 ft.  
 GRAVEL PACK INTERVALS: From 19 ft. to 35 ft., From 19 ft. to 35 ft., From 19 ft. to 35 ft., From 19 ft. to 35 ft.

6 GROUT MATERIAL:  Neat cement  2 Cement grout  3 Bentonite  4 Other 0-3' SURFACE SOIL  
 Grout Intervals: From 3 ft. to 19 ft., From 3 ft. to 19 ft., From 3 ft. to 19 ft., From 3 ft. to 19 ft.  
 What is the nearest source of possible contamination:  
 1 Septic tank  4 Lateral lines  7 Pit privy  10 Livestock pens  14 Abandoned water well  
 2 Sewer lines  5 Cess pool  8 Sewage lagoon  11 Fuel storage  15 Oil well/Gas well  
 3 Watertight sewer lines  6 Seepage pit  9 Feedyard  12 Fertilizer storage  16 Other (specify below)  
 13 Insecticide storage  
 Direction from well? South How many feet? 75

FROM	TO	LITHOLOGIC LOG	FROM	TO	LITHOLOGIC LOG
0	40	SANDY SOIL			
4	19	CLAY			
19	22	FINE SAND			
22	30	COURSE SAND			
30	35	LARGE GRAVEL, COURSE SAND			

7 CONTRACTOR'S OR LANDOWNER'S CERTIFICATION: This water well was  (1) constructed,  (2) reconstructed, or  (3) plugged under my jurisdiction and was completed on (mo/day/year) 4-13-87 and this record is true to the best of my knowledge and belief. Kansas Water Well Contractor's License No. 437 This Water Well Record was completed on (mo/day/yr) 4-28-87 under the business name of RALPH TRITZGER WELL DRILLING Signature: Ralph S. Tritzger