


1 LOCATION OF WATER WELL: County: **SUMNER** Fraction: **NW 1/4 SE 1/4 SE 1/4** Section Number: **33** Township Number: **T 30 S** Range Number: **R 1 E**

Distance and direction from nearest town or city street address of well if located within city? **3 1/2 MILE WEST 4 MILE NORTH OF BELLE PLAIN, KANSAS**

2 WATER WELL OWNER: **CHARLES INGTON** RR#, St. Address, Box #: **R.R 2 BOX 85-1** City, State, ZIP Code: **BELLE PLAIN, KANSAS 67013** Board of Agriculture, Division of Water Resources Application Number:

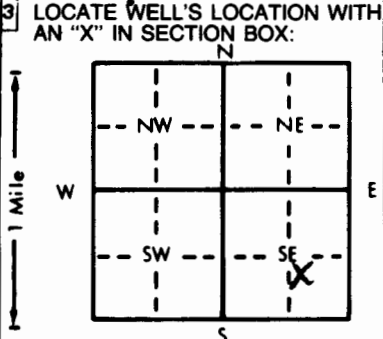

4 DEPTH OF COMPLETED WELL: **35** ft. ELEVATION: ... ft. Depth(s) Groundwater Encountered 1. **20** ft. 2. ... ft. 3. ... ft. WELL'S STATIC WATER LEVEL: **20** ft. below land surface measured on mo/day/yr **5-18-92** Pump test data: Well water was **20** ft. after **2** hours pumping **20** gpm Est. Yield: **35** gpm; Well water was ... ft. after ... hours pumping ... gpm Bore Hole Diameter: **11** in. to **35** ft., and ... in. to ... ft. WELL WATER TO BE USED AS: 5 Public water supply 8 Air conditioning 11 Injection well **1 Domestic** 3 Feedlot 6 Oil field water supply 9 Dewatering 12 Other (Specify below) 2 Irrigation 4 Industrial 7 Lawn and garden only 10 Monitoring well Was a chemical/bacteriological sample submitted to Department? Yes... No ; If yes, mo/day/yr sample was submitted Water Well Disinfected? Yes No

5 TYPE OF BLANK CASING USED: 1 Steel 3 RMP (SR) 5 Wrought iron 8 Concrete tile CASING JOINTS: Glued Clamped ... 2 PVC 4 ABS 7 Fiberglass 9 Other (specify below) Welded ... Threaded ... Blank casing diameter: **5** in. to **25** ft., Dia. ... in. to ... ft., Dia. ... in. to ... ft. Casing height above land surface: **14** in., weight **2.37** lbs./ft. Wall thickness or gauge No. **250** TYPE OF SCREEN OR PERFORATION MATERIAL: 1 Steel 3 Stainless steel 5 Fiberglass 8 RMP (SR) 10 Asbestos-cement 2 Brass 4 Galvanized steel 6 Concrete tile 9 ABS 11 Other (specify) ... 12 None used (open hole) SCREEN OR PERFORATION OPENINGS ARE: 1 Continuous slot 3 Mill slot 5 Gauzed wrapped **8 Saw cut** 11 None (open hole) 2 Louvered shutter 4 Key punched 6 Wire wrapped 9 Drilled holes 7 Torch cut 10 Other (specify) ... SCREEN-PERFORATED INTERVALS: From **25** ft. to **35** ft., From ... ft. to ... ft. From ... ft. to ... ft. From ... ft. to ... ft. GRAVEL PACK INTERVALS: From **20** ft. to **35** ft., From ... ft. to ... ft. From ... ft. to ... ft. From ... ft. to ... ft.

6 GROUT MATERIAL: **1 Neat cement** 2 Cement grout 3 Bentonite 4 Other **0-3' SURFACE SOIL** Grout intervals: From **3** ft. to **20** ft., From ... ft. to ... ft., From ... ft. to ... ft. What is the nearest source of possible contamination: **1 Septic tank** 4 Lateral lines 7 Pit privy 10 Livestock pens 14 Abandoned water well 2 Sewer lines 5 Cess pool 8 Sewage lagoon 11 Fuel storage 15 Oil well/Gas well 3 Watertight sewer lines 6 Seepage pit 9 Feedyard 12 Fertilizer storage 16 Other (specify below) 13 Insecticide storage

Direction from well? **South East** How many feet? **100**

FROM	TO	LITHOLOGIC LOG	FROM	TO	PLUGGING INTERVALS
0	3	SANDY LOAM TOP SOIL			
3	20	CLAY			
20	25	FINE SAND			
25	35	COURSE SAND			

7 CONTRACTOR'S OR LANDOWNER'S CERTIFICATION: This water well was **(1) constructed** (2) reconstructed, or (3) plugged under my jurisdiction and was completed on (mo/day/year) **5-18-92** and this record is true to the best of my knowledge and belief. Kansas Water Well Contractor's License No. **437** This Water Well Record was completed on (mo/day/yr) **5-18-92** under the business name of **PAUL METZGER WELL DIGGING DRILLING** **Paul Metzger**