


1 LOCATION OF WATER WELL: Fraction SE 1/4 SE 1/4 SE 1/4 Section Number 35 Township Number T 30 S Range Number R 1E E/W/I  
 Cor: SUMNER

Distance and direction from nearest town or city street address of well if located within city?  
 Belle Plaine, Kansas

2 WATER WELL OWNER: Loman Hatch  
 RR#, St. Address, Box # : 716 South Gordon Board of Agriculture, Division of Water Resources  
 City, State, ZIP Code : Wichita, Kansas Application Number:

3 LOCATE WELL'S LOCATION WITH AN "X" IN SECTION BOX: 4 DEPTH OF COMPLETED WELL: 40 ft. ELEVATION:

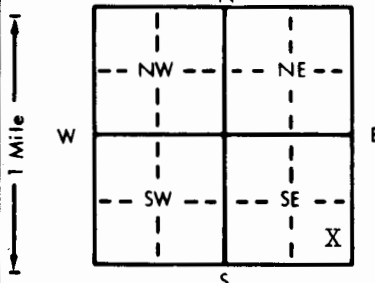

Depth(s) Groundwater Encountered 1. 17 ft. 2. ft. 3. ft.  
 WELL'S STATIC WATER LEVEL 17 ft. below land surface measured on mo/day/yr 9-23-83  
 Pump test data: Well water was ft. after hours pumping gpm  
 Est. Yield gpm: Well water was ft. after hours pumping gpm  
 Bore Hole Diameter 11 in. to ft., and in. to ft.  
 WELL WATER TO BE USED AS:  
 1 Domestic 3 Feedlot 6 Oil field water supply 9 Dewatering 11 Injection well  
 2 Irrigation 4 Industrial 7 Lawn and garden only 10 Observation well 12 Other (Specify below)  
 Was a chemical/bacteriological sample submitted to Department? Yes No X; If yes, mo/day/yr sample was submitted Water Well Disinfected? Yes X No

5 TYPE OF BLANK CASING USED:  
 1 Steel 3 RMP (SR) 5 Wrought iron 8 Concrete tile CASING JOINTS: Glued X Clamped  
 2 PVC 4 ABS 6 Asbestos-Cement 9 Other (specify below) Welded  
 7 Fiberglass Cer-Mac styrene SDR-26 Threaded

Blank casing diameter 5 in. to 25 ft., Dia in. to ft., Dia in. to ft.  
 Casing height above land surface 12 in., weight 1.59 lbs./ft. Wall thickness or gauge No. .203

TYPE OF SCREEN OR PERFORATION MATERIAL:  
 1 Steel 3 Stainless steel 5 Fiberglass 8 RMP (SR) 10 Asbestos-cement 11 Other (specify)  
 2 Brass 4 Galvanized steel 6 Concrete tile 9 ABS 12 None used (open hole)

SCREEN OR PERFORATION OPENINGS ARE:  
 1 Continuous slot 3 Mill slot 5 Gauzed wrapped 8 Saw cut 11 None (open hole)  
 2 Louvered shutter 4 Key punched 6 Wire wrapped 9 Drilled holes  
 7 Torch cut 10 Other (specify)

SCREEN-PERFORATED INTERVALS: From 25 ft. to 40 ft. From ft. to ft.  
 GRAVEL PACK INTERVALS: From 14 ft. to 40 ft. From ft. to ft.

6 GROUT MATERIAL: 1 Neat cement 2 Cement grout 3 Bentonite 4 Other  
 Grout Intervals: From 4 ft. to 14 ft. From ft. to ft.

What is the nearest source of possible contamination:  
 1 Septic tank 4 Lateral lines 7 Pit privy 10 Livestock pens 14 Abandoned water well  
 2 Sewer lines 5 Cess pool 8 Sewage lagoon 11 Fuel storage 15 Oil well/Gas well  
 3 Watertight sewer lines 6 Seepage pit 9 Feedyard 12 Fertilizer storage 16 Other (specify below) none apparent  
 13 Insecticide storage

Direction from well? How many feet?

FROM	TO	LITHOLOGIC LOG	FROM	TO	LITHOLOGIC LOG
0	3	Topsoil			
3	15	Clay			
15	23	Fine Sand			
23	37	Medium Sand			
37	40	Gray Shale			

7 CONTRACTOR'S OR LANDOWNER'S CERTIFICATION: This water well was (1) constructed, (2) reconstructed, or (3) plugged under my jurisdiction and was completed on (mo/day/year) 9-23-83 and this record is true to the best of my knowledge and belief. Kansas Water Well Contractor's License No. 236 This Water Well Record was completed on (mo/day/yr) 1-30-84 under the business name of Harp Well & Pump Service, Inc. by (signature) Mary Arnold

INSTRUCTIONS: Use typewriter or ball point pen, PLEASE PRESS FIRMLY and PRINT clearly. Please fill in blanks, underline or circle the correct answers. Send top three copies to Kansas Department of Health and Environment, Division of Environment, Environmental Geology Section, Topeka, KS 66620. Send one to WATER WELL OWNER and retain one for your records.

OFFICE USE ONLY

30

6W

SEC

35

SE 1/4

SE 1/4

SE 1/4

D