


1 LOCATION OF WATER WELL: Sumner	FRACTION SE 1/4 NW 1/4 SE 1/4	Section Number 4	Township Number T 30 S	Range Number R 1E EW
--	---	----------------------------	----------------------------------	--------------------------------

Distance and direction from nearest town or city street address of well if located within city?

Lot #20, Winzel First Addition (spec house) Peck, Kansas

2 WATER WELL OWNER: BANNON, Larry	Board of Agriculture, Division of Water Resource
RR#, ST. ADDRESS, BOX #: RR 2, Box 57	Application Number: 67039
CITY, STATE, ZIP CODE: Douglas, Kansas	

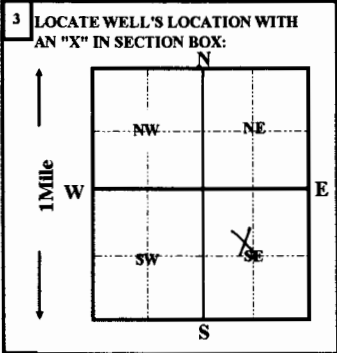

4 DEPTH OF COMPLETED WELL **28** ft. ELEVATION:

Depth(s) groundwater Encountered **1** ft. **2** ft. **3** ft.

WELL'S STATIC WATER LEVEL **12** FT. BELOW LAND SURFACE MEASURED ON **05/15/1995**

Pump test data: Well water was **ft. after** hours pumping **gpm**

Est. Yield **gpm:** Well water was **ft. after** hours pumping **gpm**

Bore Hole Diameter **12** in. to **28** ft. and in. to ft.

WELL WATER TO BE USED AS: **5** Public water supply **8** Air conditioning **11** Injection well

1 Domestic **3** Feedlot **6** Oil field water supply **9** Dewatering **12** Other (Specify below)

2 Irrigation **4** Industrial **7** Lawn and garden only **10** Monitoring well

Was a chemical/bacteriological sample submitted to Department? Yes **No** ; If yes, mo/day/yr sample was submitted **Water Well Disinfected? Yes** **No**

5 TYPE OF CASING USED:

1 Steel	3 RMP (SR)	5 Wrought iron	8 Concrete tile	CASING JOINTS: Glued <input checked="" type="checkbox"/> Clamped
2 PVC	4 ABS	6 Asbestos-Cement	9 Other (Specify below)	Welded
		7 Fiberglass	SDR-26	Threaded

Blank casing Diameter **5** in. to **24** ft., Dia in. to ft., Dia in. to ft.

Casing height above land surface **12** in., weight **2.35** lbs./ft. Wall thickness or gauge No. **.214**

TYPE OF SCREEN OR PERFORATION MATERIAL:

1 Steel	3 Stainless Steel	5 Fiberglass	8 RMP (SR)	11 other (specify)
2 Brass	4 Galvanized steel	6 Concrete tile	9 ABS	12 None used (open hole)

SCREEN OR PERFORATION OPENING ARE:

1 Continuous slot	3 Mill slot	5 Gauzed wrapped	8 Saw cut	11 None (open hole)
2 Louvered shutter	4 Key punched	6 Wire wrapped	9 Drilled holes	
		7 Torch cut	10 Other (specify)	

SCREEN-PERFORATION INTERVALS: from **24** ft. to **28** ft., From ft. to ft.

GRAVEL PACK INTERVALS: from **24** ft. to **28** ft., From ft. to ft.

6 GROUT MATERIAL: **1** Neat cement **2** Cement grout **3** Bentonite **4** Other

Grout Intervals: From **4** ft. to **24** ft. From ft. to ft. From ft. to ft.

What is the nearest source of possible contamination:

1 Septic tank	4 Lateral lines	7 Pit privy	10 Livestock pens	14 Abandon water well
2 Sewer lines	5 Cess pool	8 Sewage lagoon	11 Fuel storage	15 Oil well/Gas well
3 Watertight sewer lines	6 Seepage pit	9 Feedyard	12 Fertilizer storage	16 Other (specify below)
			13 Insecticide storage	

Direction from well? **East** How many feet? **60**

FROM	TO	LITHOLOGIC LOG	FROM	TO	PLUGGING INTERVALS
0	3	topsoil			
3	10	clay			
10	28	medium fine sand			

7 CONTRACTOR'S OR LANDOWNER'S CERTIFICATION: This water well was (1) constructed, (2) reconstructed, or (3) plugged under my jurisdiction and was completed on (mo/day/year) **05/15/1995** and this record is true to the best of my knowledge and belief. Kansas Water Well Contractor's License No. **236** This Water Well Record was completed on (mo/day/yr) **05/23/95**

Under the business name of **Harp Well & Pump Service, Inc.** by (signature) *Jane Frederick*